

LEAKE MISSISSIPPI BOARD OF WATER COMMISS

436

4-22-63

WATER WELL DRILLERS LOG

CODED

Date: 4-22, 1963, Driller: J P Thornton

County Leake

5

(Name)

(1) Owner of Land: Joe Whittington

(Name)

Carthage Miss

Estes Hill Road

(2) Location: 1/4, 1/4 Sec 10 TR

7 miles South E of Carthage

(distance)

(direction)

(Nearest Town)

(3) Topography: hilly

(Hilly)

(Flat)

(Level)

(4) Purpose of Well: Domestic

(Domestic Irrigation  
Municipal, Industrial, Other)

Description & Color of Materials  
Sand, Clay, Red Clay, Shell, etc.

Thick-  
ness  
Feet

Depth  
Feet

Red clay

25

Yellow dry sand

10

white chalk

2

real fine white sand

13

50

633

Information upon completion of well:

(1) Diameter: 2 inches.

(2) Total Depth: 50 feet.

(3) Water Level: 30 feet below top of ground.

(4) Cased to: 40, Size: 2"

(5) Screen: Size: 1 1/4, Length: 6 ft.


(6) Were any formations sealed against pollution?

yes, no.

If YES depth of formation

Why

Drillers Remarks: 395 gal. A hr.

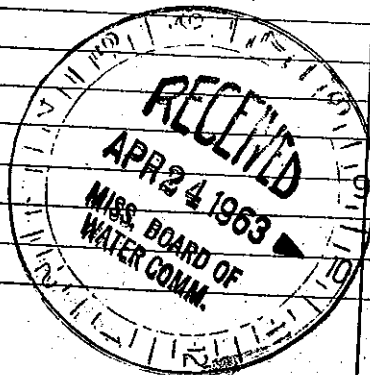

(Use Back Side)

Well No.

Retain this copy for your office files.