

LEAKE MISSISSIPPI BOARD OF WATER COMMISSIONERS

~~08~~L-41

WATER WELL DRILLERS LOG

3-13-64

CODED

CODED

Date: 3-13, 1964, Driller: J P Thornton, County Leake

(Name)

(1) Owner of Land: Tommy Brooke
 (Name)
Carthage Miss
 (Address)
 CODE 6
 (2) Location: 1/4, 2nd Sec 10 8
25 10 7
5 miles S of Carthage
 (distance) (direction) (Nearest Town)
 (3) Topography: Hills
 (Hilly) (Flat) (Level)
 (4) Purpose of Well: Domestic
 (Domestic Irrigation
 Municipal, Industrial, Other)

Description & Color of Materials Sand, Clay, Red Clay, Shell, etc.	Thick- ness Feet	Depth Feet
red clay	35	
dry sand	40	
real fine sand	8	
white water sand	20	
		103


5778 - 560

Information upon completion of well:

(1) Diameter 2 inches.
 (2) Total Depth 103 feet.
 (3) Water Level 84 feet below top of ground.
 (4) Cased to 93, Size _____
 (5) Screen: Size 1/4, Length 6 ft
 (6) Were any formations sealed against pollution?
 _____ yes, _____ no.

CODED

If YES depth of formation _____
 Why _____
 Drillers Remarks: Face Pump

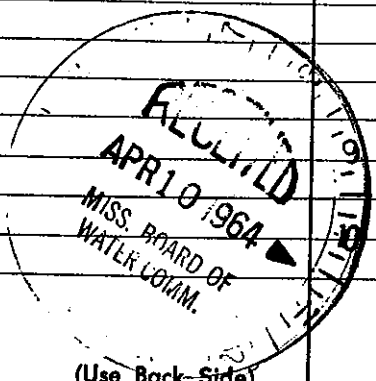

(Use Back-Side)

Well No.