

Leake  
L 48  
9-4-75

MISSISSIPPI  
BOARD OF WATER COMMISSIONERS  
416 North State Street  
Jackson, Mississippi 39201

**CODED**

WATER WELL DRILLERS LOG

9-4-75 date well completed  
Thomas & Son firm name  
Leake county well located

LANDOWNER: Albie Kenton  
Carthage, Miss  
(mailing address)

description of formations encountered	from to	
	from	to
Red Clay	0	5
White CHALK	5	15
SAND	15	62
BLACK DIRT	62	145
Rock & shell	145	176
Green SAND	176	207

WELL LOCATION:  
sec. 23 T. 10 N. R. 3 E.  
S W  
5 miles 32 of Carthage  
(distance) (direction) (nearest town)

WELL PURPOSE:  
(home, irrigation, municipal, industrial)

WELL COMPLETION DATA:

(1) diameter (inches) 2

(2) total depth (feet) 207

(3) static water level (feet) 30 <sup>below</sup> <sub>above</sub> top of ground

(4) casing pc 145  
(material) (depth)  
2 if telescope see back.  
(size)


(5) screen open  
(length) (depth to top)  
(size) (material)

(6) pump 1 8  
(HP) (yield gpm)  
Eke  
(type power)

(7) electric log NO  
(yes or no)  
(organization running log)

(8) how well bottom plugged open

**CODED**

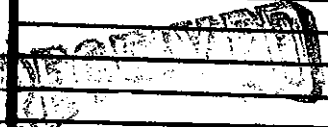

SEP 10 1975

MISS. BD. OF WATER COMM.

DRILLERS REMARKS: