County: LEAKE	Well Driller Report and Well Log		For Office Use Only:
Permit #:	-	Ū.	Aquifer: Well #: L- 59
Driller Thomas Dr. 11, 10.	Mississippi Department of Office of Land and		Well #: <u>L- 59</u>
Date drilling completed: $13 - 14 - 05$	P.O. Box 10631		L. S. Elevation:
Date drining completed. <u>77777</u>	Jackson, MS 39289-0631 (601)961-5210		E-log #:
	(601)354-69	20 (fax)	
State Law requires that this r		ller in detail and filed wit	h the Department within
30 days of completion of drill Well Owner Inform	ing of the well.	Wel	I Location Alla (5
Owner Name Kin CALA	Imation 32.69394 Well Latitude: Standing (circle of Lat/Long (circl		- 89. 79265 "Longitude: °,
5-27 5	the life of	32 41 35	89 26 3
Mailing Address: JOOT J	THNA ING FILE MYM	ethod of Lat/Long (circle o	one): Conventional Survey,
· .	NIS 39051 N State Zip Code	USGS quad Hand-held	d GPS, Survey-grade GPS √
CANTHAGE	115 39051 N	IN 1/4 NE 1/4 Sec 26	Twn /ON Rng O
City /	State Zip Code	istance Direction	Neorest Town
Telephone No. ()		<u>2</u> Miles <u>Eas</u>	Nearest Town of <u>FreeNy</u>
	Well Da		
Purpose of Well (circle one) Home			P. HANY
Purpose of well (circle one) Home		Irrigation Fish Cultur	e Other: <u>Other</u>
Date well drilling started: $10 - 1$	4-05 Date w	vell drilling completed: <u>/</u>	3-14-25
If flowing, method of flow regulation:	Valve Other (de	escribe)	
Static Water Level: 60 fee	et above or below (circle one) la	and surface Date measur	red: 10 - 14 -05
Method of Measurement (circle one)	steel tape electric tape		-
Hole depth: $\underline{/40}$ Well			
Hole depth: <u>77</u> Well	depth: ///	Well grouted to a depth	of <u>[0</u> feet
Type of grout (circle one): Cement			
Casing length: $\frac{20}{120}$ feet C	Casing diameter:4	inches Type of casin	g: PUC
Casing length: 20 feet C Screen length: 20 feet S	Sereen diameter: 4	inches Type of screen	: PUC sourced
Screen slot size: ,010 inch			
Type of completion (circle all applicab			
Type of completion (encie an applicat			
	Other (describe):		
Top of lap pipe or reduction in casing:	feet. If tel	escoped or more than one	e s <mark>creen, describe on back</mark> of
Logs run (circle all applicable): No log	g run Electric Gamma Ray	Density Sonic Neutro	on Other:
Name of organization running log(s):			
I certify that the well was drilled, constructed	· •		ne Mississippi Department of
Environmental Quality and/or the Mississippi	Department of Health regulations a	nd state laws.	~
OICAT.	m 110	// 1	-
	1AS 0-147	fait f	Menn-
Print Name of Water Well Contractor a	and License No.	Signature o	f Water Well Contractor


If well telescopes please sketch below and show depths.

att 35 366 RVVJO :YB

L- 59

Ground Level	Description of Formations Encountered	From To
	- Red Durt	05
	Yellow SANd	5 Z1
	Gray CLAY	21 60
	White Smid	21 60 60 140

If more than one screen, show location of each on sketch

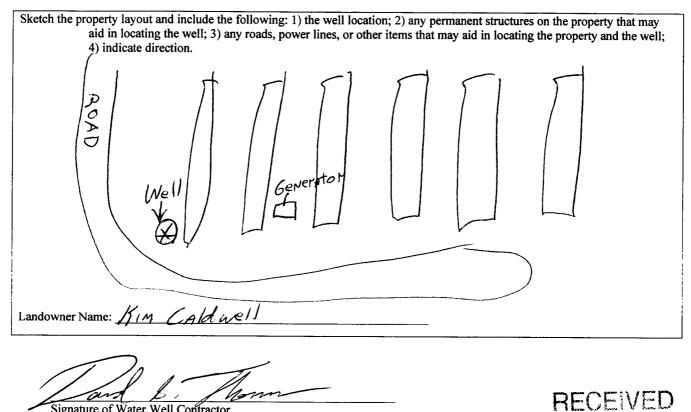

Signature of Water Well Contractor

OCT 2 6 2005 BYOLWR

	STATE WI	ELL REPORT			
County: Leake Pu	-	art 2 Completion Report	For Offic	e Use Only:	
N	•	t of Environmental Quality	Aquifer: Well #:	69	
Driller:		nd Water Resources	Well #:	L- 51	
Date completed: $10 - 14 - 05$		Box 10631 15 39289-0631	Elevation:		
		961-5210			
This report must be prepared by the	· · ·	4-6938 (fax) detail and filed with the De	nauturant withiw	20 days of the	
installation of pump. A copy of Part 1				So days of the	
Well Owner Information	Well Location				
Owner Name: Kim Caldurell		Latitude: 32 69394 Longitude: 89 44265			
Mailing Address: 5001 Standing	Method of Lat/Long (circle one): Conventional Survey,				
Carthinge MS City State	¼ ¼ Sec_2	26 _{Twn} /0	V Rng 8E		
City / State	Zip Code	Distance Direction	Nearest 7	`own	
Telephone No. ()		2 Miles EAST of Freeny			
Ритр Туре		Po	wer Type	·	
Circle one		Circle one			
Air Lift Jet	ubmorstble	Diesel Engine Gaso	oline Engine	Natural Gas	
Bucket Piston Tu	urbine	Electric Motor Han	d	Tractor PTO	
Centrifugal Rotary F	lowing Well		er (specify):		
Other (specify):		Horse Power Rating of Mot	or: <u>/2</u>		
Date Pump Installed: 10 - 14 - 05		Setting Depth:	2	feet	
Rated Pump Capacity:Ga	llons Per Minute	Number of Stages: _//			
Pump Test Data			easuring Water L	evel	
Date Well Tested:		С	ircle one		
tatic Water Level (A): 60 Feet Bel	ow Land Surface	Air Line Electric M	leasuring Line	Steel Tape	
02	ow Land Surface	Other (specify):			
Drawdown [(B) – (A)]: <u>/2</u> Feet Bel	ow Land Surface	For flowing well, measured	shut in head:	feet	
Test Pumping Rate: 25 Gallons Per Minute		Well yielded	GPM with a	drawdown of	
	,	faat aftar		hours of pumping	
Duration of Pump Test (minimum 4 hours):	hours				
Duration of Pump Test (minimum 4 hours):	*				
HEREBY CERTIFY that the above statement	s are true to the bes	st of my knowledge.	1-11		
HEREBY CERTIFY that the above statement David S. Mamas	is are true to the bes $\mathcal{O} - 147$	st of my knowledge.	Hom		
HEREBY CERTIFY that the above statement	is are true to the bes $\mathcal{O} - 147$	st of my knowledge.	Hom	ECEIVE 300 2 8 200	

. 4.

₹ 100 y 11