

WATER WELL DRILLERS LOG


8-31-60
 Date: 8-31, 1960, Driller: J P Thornton County, La Belle
 (Name)

1) Owner of Land (Name)	Description & Color of Materials Sand, Clay, Red Clay, Shell, etc.	Thick- ness Feet	Depth Feet
Freddie Wilcher	Clay	34	
Carthage Route 3 LAUREL HI (Address)	White Chalk sand	20	
2) Location: 1/4, 1/4, Sec. 9 T1DR9	Real fine fine Willow	10	
11 miles East of Carthage (distance) (direction) (Nearest Town)	White water sand	8	
3) Topography: Hilly (Hilly) Flat (Flat) Level (Level)			
4) Purpose of Well: Domestic household (Domestic Irrigation Municipal, Industrial, Other)			

Information upon completion of well:

- (1) Diameter 2 inches.
- (2) Total Depth 68 feet.
- (3) Water Level 50 feet below top of ground.
- (4) Cased to 63, Size 2"
- (5) Screen: Size 1/4 80 gauge, Length 5 ft.
- (6) Were any formations sealed against pollution?
 yes, no,

If YES depth of formation _____
 Why _____
 Drillers Remarks: 200 gallon per hour

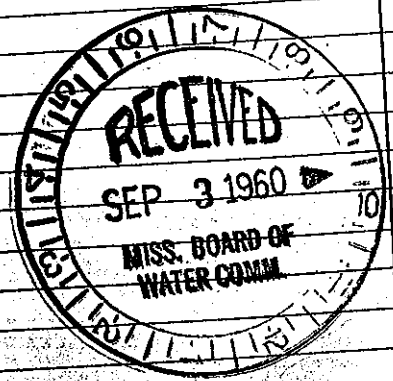

Well No.

(Use Back Side)