

LEAKE

M3

5-30-62

WATER WELL DRILLERS LOG

CODED

Date: 5-30, 1962, Driller: THOMAS & SON County LEAKE  
(Name)

(1) Owner of Land: <u>B.H. Pisher</u> (Name)	Description & Color of Materials Sand, Clay, Red Clay, Shell, etc.	Thick- ness Feet	Depth Feet
<u>Madden, Miss</u> (Address)	<u>Red clay &amp; sand</u>	<u>60</u>	<u>0 to 60</u>
(2) Location: <u>NE 1/4, NW 1/4, Sec. 35 T14 R9</u> miles <u>IN</u> <u>Madden</u> (distance) (direction) (Nearest Town)	<u>SAND</u>	<u>12</u>	<u>72</u>
(3) Topography: <u>(Hilly)</u> (Flat) (Level)			
(4) Purpose of Well: <u>Domestic</u> (Domestic Irrigation Municipal, Industrial, Other)			


Information upon completion of well:

- (1) Diameter 2 inches.
- (2) Total Depth 72 feet.
- (3) Water Level 60 feet below top of ground.
- (4) Cased to 67, Size 2
- (5) Screen: Size 60, Length 6 ft.
- (6) Were any formations sealed against pollution?  
\_\_\_\_\_ yes,  no.

If YES depth of formation \_\_\_\_\_

Why \_\_\_\_\_

Drillers Remarks: \_\_\_\_\_

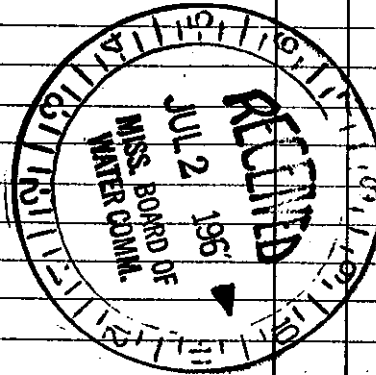

Well No.

(Use Back Side)

Retain this copy for your office files.