

LEAKE

MISSISSIPPI BOARD OF WATER COMMISSIONERS

M 4

WATER WELL DRILLERS LOG

CODED

6-1-62

Date: June 1, 1962, Driller: Thomas & Son County Leake (Name)

(1) Owner of Land: <u>Clayton Callahan</u> (Name)	Description & Color of Materials Sand, Clay, Red Clay, Shell, etc.	Thick- ness Feet	Depth Feet
<u>Carthage, Miss. Rt. #1</u> (Address)	<u>Red clay &amp; sand</u>	<u>80</u>	<u>0-80</u>
<u>5 1/2 of</u>	<u>Black dirt</u>	<u>67</u>	<u>147</u>
(2) Location: <u>SE 1/4, SE 1/4, Sec. 21 T10R9</u>	<u>Rock &amp; shell</u>	<u>30</u>	<u>177</u>
<u>3 miles north west of Madden</u> (distance) (direction) (Nearest Town)	<u>SAND &amp; CHALK &amp; shell</u>	<u>30</u>	<u>207</u>
(3) Topography: <u>Hilly</u> (Hilly) (Flat) (Level)			
(4) Purpose of Well: <u>Domestic</u> (Domestic Irrigation Municipal, Industrial, Other)			


Information upon completion of well:

- (1) Diameter 2 inches.
- (2) Total Depth 207 feet.
- (3) Water Level 65 feet below top of ground.
- (4) Cased to 147 ft, Size 2"
- (5) Screen: Size \_\_\_\_\_, Length \_\_\_\_\_
- (6) Were any formations sealed against pollution?  
\_\_\_\_\_ yes,  no.

If YES depth of formation \_\_\_\_\_

Why \_\_\_\_\_

Drillers Remarks: \_\_\_\_\_

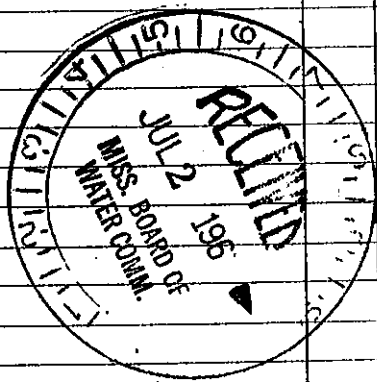

Well No.

(Use Back Side)

Mail this copy to Board of Water Commissioners 429 Miss. St. Jackson, Miss.