

Leake
MS

9-66

MISSISSIPPI BOARD OF WATER COMMISSIONERS

CODED

WATER WELL DRILLERS LOG

Date: 9-1, 1966, Driller: J. P. Thornton County Leake
(When well drilled) (Name) (Where well is located)

(1) Owner of Land: C. C. Hanna
(Name)
Route # 3 Carthage, Miss.
(Address)
5 1/2 S 1/2 NW
(2) Location: 1/4, 1/4, Sec. 19 T10R9
10 miles SE of Carthage
(distance) (direction) (Nearest Town)

(3) Topography: X
(Hilly) (Flat) (Level)

(4) Purpose of Well: Domestic
(Domestic Irrigation
Municipal, Industrial, Other)

Description & Color of Materials Sand, Clay, Red Clay, Shell, etc.	Thick- ness Feet	Depth Feet
<u>Yellow clay</u>	<u>30</u>	<u>30</u>
<u>Sand & Clay</u>	<u>10</u>	<u>40</u>
<u>Sand & rock</u>	<u>2</u>	<u>42</u>
<u>Fine purple sand</u>	<u>8</u>	<u>50</u>
<u>White Chalk</u>	<u>1</u>	<u>51</u>
<u>Yellow sand</u>	<u>15</u>	<u>66</u>
<u>White water sand</u>	<u>18</u>	<u>84</u>

Information upon completion of well:

(1) Diameter 2 inches.

(2) Total Depth 84 feet.

(3) Water Level 57 feet below top of ground.

(4) Cased to 79, Size 2"

(5) Screen: Size 2", Length 5 ft.

(6) Were any formations sealed against pollution?
no

If YES depth of formation _____


Why _____

Drillers Remarks: _____

Yield in gpm: 5 gals per min

Size pump: 1/2 HP Stanite Pump

Type power: 110

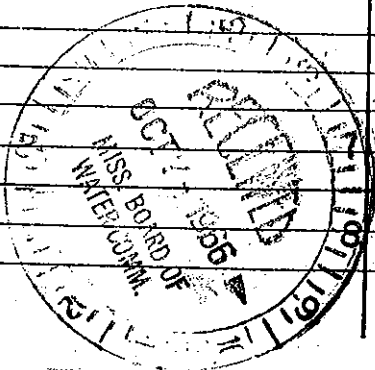

Retain this copy for your office files.