

LEAKE
M6
3-68

MISSISSIPPI
BOARD OF WATER COMMISSIONERS
416 North State Street
Jackson, Mississippi 39201

CODED

WATER WELL DRILLERS LOG

3-26-1968 J P Hamton Teate County
date well completed firm name county well located


LANDOWNER:
Mellie Ruth E. Bryson
Carehage, Miss
(mailing address)

description of formations encountered	from	to
san + clay	60	68
Black dirt	125	185
Yellow sand	17	202
Black	11	213
Black	2	215
Black sand	20	235
Black	2	237
gray water sand	18	255

WELL LOCATION:
sec 7 T 10 N R 9 E
9 miles S^SE of Carehage
(distance) (direction) (nearest town)

WELL PURPOSE: Domestic
(home, irrigation, municipal, industrial)

- WELL COMPLETION DATA:
- (1) diameter (inches) 2"
 - (2) total depth (feet) 253'
 - (3) static water level (feet) 129 below above top of ground.
 - (4) casing galv 253' (material) (depth)
(size) if telescope see back.
 - (5) screen 3' ft (length) (depth to top)
1/4 SS (size) (material)
 - (6) pump 1/2 (HP) 6 gpm (yield gpm)
230 (type power)
 - (7) electric log X (yes or no)
(organization running log)
 - (8) how well bottom plugged Screen

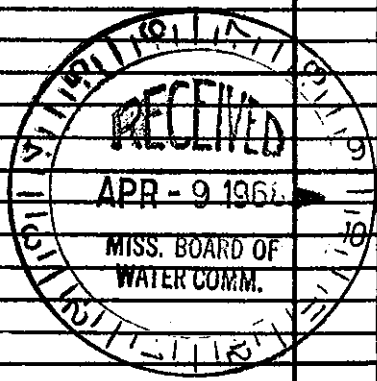

DRILLERS REMARKS: 366 PPH