

Reale  
M 7  
2.68

MISSISSIPPI BOARD OF WATER COMMISSIONERS

CODED.

WATER WELL DRILLERS LOG

Date: 2-8, 1968, Driller: Thomas S. D County Leake  
(When well drilled) (Name) (Where well is located)



(1) Owner of Land: L. H. Bryan  
(Name)  
Madden, Miss  
(Address)  
 Location: Center of E.C. 1/4, Sec. 27 T. 10 R. 9  
1 miles NW, of Madden  
(distance) (direction) (Nearest Town)  
 (3) Topography: (Hilly) (Flat) (Level)  
 (4) Purpose of Well: (Domestic Irrigation)  
Municipal, Industrial, Other

Description & Color of Materials Sand, Clay, Red Clay, Shell, etc.	Thick- ness Feet	Depth Feet
<u>Pipe Clay</u>	<u>0</u>	<u>30</u>
<u>Dry Sand</u>	<u>30</u>	<u>80</u>
<u>Coarse Sand</u>	<u>80</u>	<u>100</u>
<u>Black Dirt</u>	<u>100</u>	<u>190</u>
<u>Rock &amp; Shell</u>	<u>190</u>	<u>229</u>
<u>Green Sand</u>	<u>229</u>	<u>260</u>

Information upon completion of well:

(1) Diameter 2 inches.  
 (2) Total Depth 260 feet.  
 (3) Water Level 80 feet below top of ground.  
 (4) Cased to 210, Size 2"  
 (5) Screen: Size open, Length \_\_\_\_\_  
 (6) Were any formations sealed against pollution?  
 \_\_\_\_\_ yes, X no.  
 If YES depth of formation \_\_\_\_\_  
 Why \_\_\_\_\_  
 Drillers Remarks: \_\_\_\_\_  
 Yield in gpm: 7  
 Size pump: J.H.P.  
 Type power: Elec.

CODED

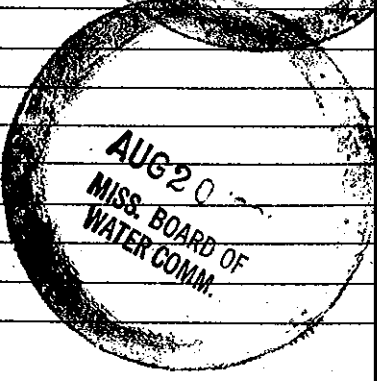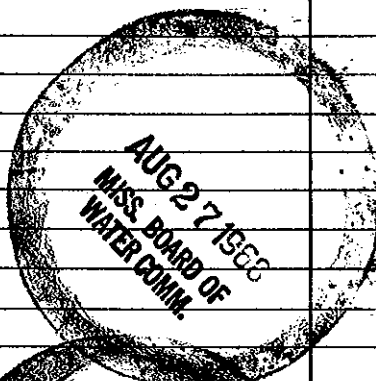

Mail this copy to Board of Water Commissioners 429 Miss. St. Jackson, Miss.