

**LEAKE**  
**M 69**  
**9-11-74**

MISSISSIPPI  
 BOARD OF WATER COMMISSIONERS  
 416 North State Street  
 Jackson, Mississippi 39201  
**CODED**  
**WATER WELL DRILLERS LOG**

date well completed 9-11-74 1974 firm name Thomas & Son county well located Leake


LANDOWNER: James Callahan  
 Madden, Miss  
 (mailing address)

description of formations encountered	from to	
	feet	feet
red clay	0	17
red sand	17	90
chmky sand	90	102
yellow sand	102	112

WELL LOCATION:  
 sec 29 T. 10 N R. 9 E  
 3 miles NW of Madden  
 (distance) (direction) (nearest town)

WELL PURPOSE:  
 (home, irrigation, municipal, industrial)

- WELL COMPLETION DATA:
- (1) diameter (inches) 2
  - (2) total depth (feet) 112
  - (3) static water level (feet) 80 below top of ground.
  - (4) casing 1 1/2" 102' (material) (depth)  
 2" (size) If telescope see back.
  - (5) screen 5' 107' (length) (depth to top)  
 2" 3/8 slot PVC (size) (material)
  - (6) pump 1/2 HP 6 (yield gpm)  
 Elec (type power)
  - (7) electric log no (yes or no)
  - (8) how well bottom plugged part

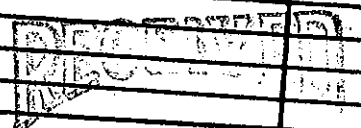

NOV 13 1974

MISS. BD. OF WATER COMM

DRILLERS REMARKS: