

**LEAKE**  
**M70**  
**10/29/74**

MISSISSIPPI  
 BOARD OF WATER COMMISSIONERS  
 416 North State Street  
 Jackson, Mississippi 39201

**CODED**

**WATER WELL DRILLERS LOG**

*F. D. Conroy Leake*  
 firm name county well located

*10-29-74*  
 date well completed

LANDOWNER: *Jim Scott*

description of formations encountered	from	to
<i>Red clay</i>	<i>0</i>	<i>22</i>
<i>Sand clay</i>	<i>27</i>	<i>42</i>

(mailing address)

**WELL LOCATION:**


sec *19* T *100* N *R 90* E  
*1/2* miles *N* of *Free Trade*  
 (distance) (direction) (nearest town)

**WELL PURPOSE:**

(home, irrigation, municipal, industrial)

**WELL COMPLETION DATA:**

- (1) diameter (inches) *2"*
- (2) total depth (feet) *112'*
- (3) static water level (feet) *20* below above top of ground.
- (4) casing *2"* *PVC* *42'*  
 (material) (depth)  
*2"*  
 (size) If telescope see back.
- (5) screen *2"* *PVC* *35'*  
 (length) (depth to top)  
*2"* *PVC*  
 (size) (material)
- (6) pump *1/2* *105*  
 (HP) (yield gpm)  
*Elec.*  
 (type power)
- (7) electric log *NO*  
 (yes or no)  
*Conf*  
 (organization running log)
- (8) how well bottom plugged

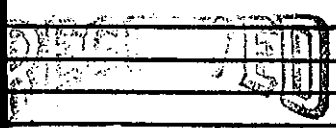

NOV - 4 1974

DRILLERS REMARKS:

MISS. BD. OF WATER COMM