

County: Leake
 Permit #: _____
 Driller: Thomas Drilling
 Date drilling completed: 10-18-05

Well Driller Report and Well Log

Mississippi Department of Environmental Quality
 Office of Land and Water Resources
 P.O. Box 10631
 Jackson, MS 39289-0631
 (601)961-5210
 (601)354-6938 (fax)

For Office Use Only:
 Aquifer: _____
 Well #: M-82
 L. S. Elevation: _____
 E-log #: _____

State Law requires that this report be prepared by the driller in detail and filed with the Department within 30 days of completion of drilling of the well.

Well Owner Information		Well Location	
Owner Name: <u>Harry Payne</u>		Latitude: <u>32° 44' 18"</u>	Longitude: <u>89° 23' 03"</u>
Mailing Address: <u>4149 Buena Vista Ave.</u>		Method of Lat/Long (circle one): <u>Conventional Survey</u> , <u>USGS quad</u> , Hand-held GPS, Survey-grade GPS	
<u>Oakland</u> <u>MS</u> <u>394618</u>	City State Zip Code	NW ¼ NW ¼ Sec <u>8</u> Twn <u>10N</u> Rng <u>9E</u>	
Telephone No. <u>(501) 654-4674</u>		Distance <u>4</u> Miles	Direction <u>W</u> of Nearest Town <u>Lake Hill</u>

Well Data

Purpose of Well (circle one) Home Industrial Public Supply Irrigation Fish Culture Other: _____

Date well drilling started: 10-18-05 Date well drilling completed: 10-18-05

If flowing, method of flow regulation: Valve _____ Other (describe) _____

Static Water Level: 100 feet above or below (circle one) land surface Date measured: 10-18-05

Method of Measurement (circle one) steel tape electric tape air line other: _____

Hole depth: 220' Well depth: 220' Well grouted to a depth of 10 feet

Type of grout (circle one): Cement Bentonite Mix

Casing length: 210 feet Casing diameter: 4 inches Type of casing: PVC

Screen length: 10 feet Screen diameter: 4 inches Type of screen: PVC

Screen slot size: .010 inches Setting depth: From 210 feet to 220 feet

Type of completion (circle all applicable): Gravel packed Underreamed Telescoped Open hole Natural Development

Other (describe): _____

Top of lap pipe or reduction in casing: _____ feet. **If telescoped or more than one screen, describe on back of page**

Logs run (circle all applicable): No log run Electric Gamma Ray Density Sonic Neutron Other: _____

Name of organization running log(s): _____

I certify that the well was drilled, constructed, and completed in accordance with all applicable requirements of the Mississippi Department of Environmental Quality and/or the Mississippi Department of Health regulations and state laws.

David S. Thomas 0-147
 Print Name of Water Well Contractor and License No.

David S. Thomas
 Signature of Water Well Contractor

If well telescopes please sketch below and show depths.

BY OLWR


M-82

Ground Level

Description of Formations Encountered	From	To
CLAY & DIRT	0	4
Red SAND	4	29
White SAND	29	89
GRAY CLAY	89	120
Rock & CLAY w/Green	120	150
Rock	150	152
Rock & GRAY CLAY	152	190
GRAY SAND	190	220

If more than one screen, show location of each on sketch

Sketch the property layout and include the following: 1) the well location; 2) any permanent structures on the property that may aid in locating the well; 3) any roads, power lines, or other items that may aid in locating the property and the well; 4) indicate direction.

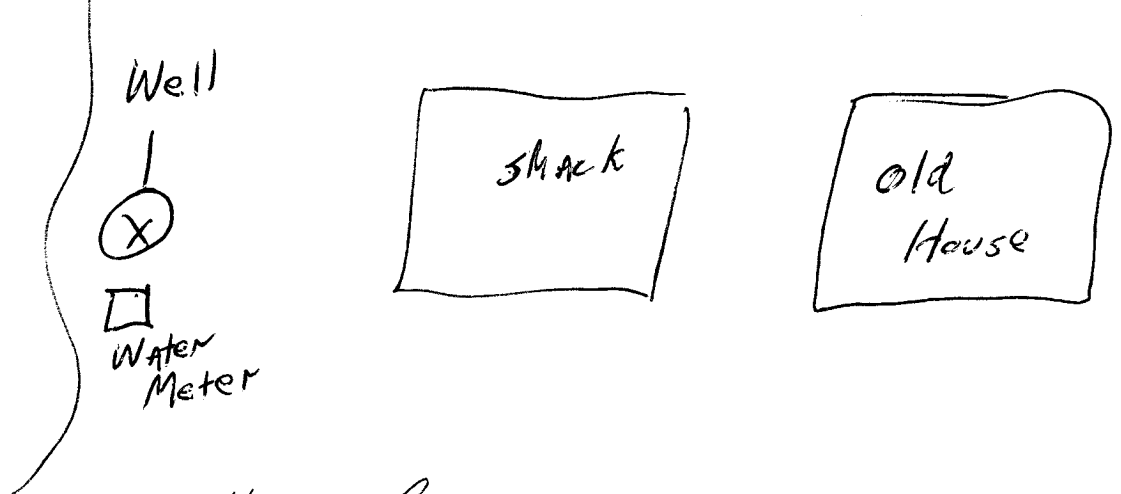

Landowner Name: HARRY PAYNE

Paul S. Thomas
Signature of Water Well Contractor

RECEIVED
OCT 26 2006
BY: OLWA

STATE WELL REPORT

Part 2

Pump Installer's Completion Report

County: LAKE
 Permit #: _____
 Driller: THOMAS Drilling
 Date completed: 10-18-05

Mississippi Department of Environmental Quality
 Office of Land and Water Resources
 P.O. Box 10631
 Jackson, MS 39289-0631
 (601)961-5210
 (601)354-6938 (fax)

For Office Use Only:

Aquifer: _____
 Well #: M-82
 Elevation: _____

This report must be prepared by the pump installer in detail and filed with the Department within 30 days of the installation of pump. A copy of Part 1 of this report must be attached to this report.

Well Owner Information	Well Location
Owner Name: <u>HARRY PAYNE</u>	Latitude: <u>32.73835°</u> Longitude: <u>-89.38411</u>
Mailing Address: _____ <u>6149 BUENAVISTA AVE</u> <u>OAKLAND CA 94612</u> City State Zip Code	Method of Lat/Long (circle one): Conventional Survey, <u>USGS MAP</u> , Hand-held GPS, Survey-grade GPS
Telephone No. <u>(601) 654-4674</u>	<u>1/4</u> <u>4</u> <u>10N</u> <u>9E</u> Twn Rng
	Distance Direction Nearest Town <u>4</u> Miles <u>W</u> of <u>LAUREL HILL</u>

Pump Type Circle one	Power Type Circle one
Air Lift Jet <input checked="" type="radio"/> <u>Submersible</u>	Diesel Engine Gasoline Engine Natural Gas
Bucket Piston Turbine	<u>Electric Motor</u> Hand Tractor PTO
Centrifugal Rotary Flowing Well	Windmill Other (specify): _____
Other (specify): _____	Horse Power Rating of Motor: <u>1/2</u>
Date Pump Installed: <u>10-18-05</u>	Setting Depth: <u>140</u> feet
Rated Pump Capacity: <u>7</u> Gallons Per Minute	Number of Stages: <u>10</u>

Pump Test Data	Method of Measuring Water Level Circle one
Date Well Tested: <u>10-18-05</u>	<u>Air Line</u> Electric Measuring Line Steel Tape
Static Water Level (A): <u>100</u> Feet Below Land Surface	Other (specify): _____
Pumping Water Level (B): <u>120</u> Feet Below Land Surface	For flowing well, measured shut in head: _____ feet
Drawdown [(B) - (A)]: <u>20</u> Feet Below Land Surface	Well yielded _____ GPM with a drawdown of _____ feet after _____ hours of pumping
Test Pumping Rate: <u>9</u> Gallons Per Minute	
Duration of Pump Test (minimum 4 hours): <u>1</u> hours	

I HEREBY CERTIFY that the above statements are true to the best of my knowledge.

DAVID J. THOMAS 0-147 [Signature]
 Print Name of Pump Installer and License No. (if applicable) Signature of Pump Installer

RECEIVED
 OCT 26 2005
 BY OLWR