

State Well Report Part I - Driller's Log

Mississippi Department of Environmental Quality
Office of Land and Water Resources
P.O. Box 10631
Jackson, MS 39289-0631
(601)961-5210
(601)354-6938 (fax)

County: LEAKE
 Permit #: _____
 Driller: Thomas Drilling
 Date drilling completed: 8-2-06

For Office Use Only:
 Aquifer: _____
 Well #: M-84
 L. S. Elevation: _____
 E-log #: _____

State Law requires that this report be prepared by the license holder responsible for the work and filed with the Department at the above address within 30 days of completion of drilling of the well or borehole.

Information on Well Owner <i>(Landowner if borehole is not for a water well)</i>	Well or Borehole Location
Owner Name: <u>Jack Sanders #2</u>	Latitude: <u>32° 44.934'</u> Longitude: <u>89° 24.351'</u>
Mailing Address: <u>2521 Hudson Rd</u>	Method of Lat/Long (circle one): <u>Conventional Survey</u>
<u>Carthage MS 39051</u>	USGS quad, <u>Hand-held GPS</u> , Survey-grade GPS
City State Zip Code	<u>SE 1/4 NE 1/4 Sec 6 Twn 10N Rng 9E</u>
Telephone No. <u>601 416-2444</u>	Distance Direction Nearest Town <u>2 Miles SE of SUNRISE</u>

Well / Borehole Data

Date drilling started: 8-2-06 Date drilling completed: 8-2-06 Hole depth: 205 Hole diameter: 4"

Location of the source of any surface water used for drilling: COMMUNITY & PRIVATE WELL
 Method of dosing and volume of Chlorine used in drilling and development: 1 LB CHLORINE IN WASH

Logs run (circle all applicable): No log run Electric Gamma Ray Density Sonic Neutron Other: _____
 Name of organization running log(s): _____

Purpose of borehole (check one): Water Well Geotechnical/Geological Investigation _____ Ground Source Heat Pump _____
 Seismic Survey _____ Other (describe) _____
If drilling is not related to water well construction, skip the remainder of this block

Purpose of Well (check one): Home _____ Industrial _____ Public Supply _____ Irrigation _____ Fish Culture _____ Other: Poultry

If a flowing well, method of flow regulation: Valve _____ Other (describe) _____

Static Water Level: 80' feet above or below (circle one) land surface Date measured: 8-2-06

Method of Measurement (circle one) steel tape electric tape air line other: _____

Well depth: 205 Well grouted to a depth of 10' feet Type of grout (circle one) Neat Cement Bentonite Mix

Casing length: 185 feet Casing diameter: 4 inches Type of casing: PVC

Screen length: 20 feet Screen diameter: 4 inches Type of screen: PVC

Screen slot size: .010 inches Setting depth: From 185 feet to 205 feet

Type of completion (circle all applicable): Gravel packed Underreamed Telescoped Open hole Natural Development
 Other (describe): _____

Top of lap pipe or reduction in casing: _____ feet. *If telescoped or more than one screen, describe on next page*


Form: OLWR-SWR-1A

RECEIVED
AUG 16 2006
BY: OLWR

M-84

The sketch below only required for water wells

If well telescopes, show depths on sketch
Ground Level →

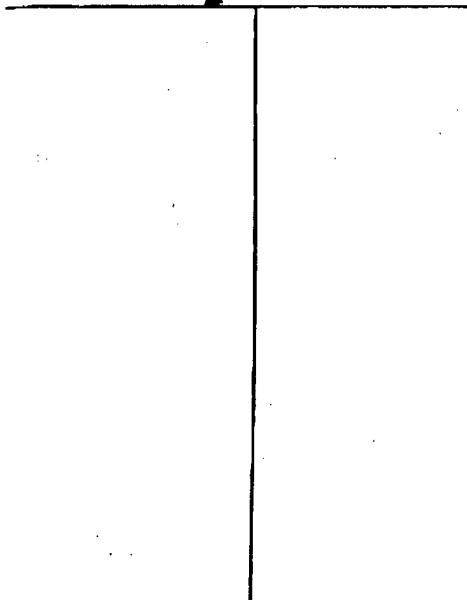

Description of formations encountered must be provided for all wells and boreholes, unless specifically exempted by regulations

Description of Formations Encountered	From (depth) To (depth)	
	Ground Level	
White Sand	0	20
Mixed CLAY	20	27
GRAY CLAY	27	86
Rock	86	89
Green Sand & Shell	89	109
Rock	109	119
Green Sand & Shell	119	138
Green Sand & Gray Shls	138	151
Mod Gray Sand	151	180
Coarse Gray Sand	180	205

If more than one screen, show location of each on sketch

Sketch the property layout and include the following: 1) the well location; 2) any permanent structures on the property that may aid in locating the well; 3) any roads, power lines, or other items that may aid in locating the property and the well; 4) a north arrow.

Landowner Name: Jack Sanders #2

Form: OLWR-SWR-1A

I certify that the well/borehole was drilled, constructed, and completed in accordance with all applicable requirements of the Mississippi Department of Environmental Quality and the Mississippi Department of Health regulations, if applicable, and state laws.

David S. Thomas 0-147

8-2-06

Print Name of Responsible Licensee and License No.

Date

Signature of Licensee

RECEIVED

AUG 16 2006

BY: OLWF

STATE WELL REPORT

Part 2

Pump Installer's Completion Report
 Mississippi Department of Environmental Quality
 Office of Land and Water Resources
 P.O. Box 10631
 Jackson, MS 39289-0631
 (601)961-5210
 (601)354-6938 (fax)

County: Leake
 Permit #: _____
 Driller: Thomas Drilling
 Date completed: 8-3-06
 Copy information from block on Part 1

For Office Use Only:
 Aquifer: _____
 Well #: M-84
 Elevation: _____

This part of the report must be completed by a licensed water well contractor or a licensed pump installer. A copy of Part 1 of the report must be attached and both parts filed with the Department at the above address within 30 days of well completion.

Well Owner Information	Well Location
Owner Name: <u>Jack Sanders #12</u>	Latitude: <u>32° 44.934</u> Longitude: <u>89° 24.351</u>
Mailing Address: <u>2521 Hudson Rd</u>	Method of Lat/Long (check one): Conventional Survey <u>21</u>
<u>Carthage MS 39051</u>	USGS quad _____ Hand-held GPS <input checked="" type="checkbox"/> Survey-grade GPS _____
City State Zip Code	<u>1/4</u> Sec <u>6</u> T <u>10N</u> R <u>9E</u>
Telephone No. <u>(601) 416-2444</u>	Distance Direction Nearest Town
	<u>2</u> Miles <u>SE</u> of <u>SUNRISE</u>

Pump Type Circle one	Power Type Circle one
Air Lift Jet <input checked="" type="radio"/> Submersible	Diesel Engine Gasoline Engine Natural Gas
Bucket Piston Turbine	<input checked="" type="radio"/> Electric Motor Hand Tractor PTO
Centrifugal Rotary Flowing Well	Windmill Other (specify): _____
Other (specify): _____	Horse Power Rating of Motor: <u>1/2</u>
Date Pump Installed: <u>8-3-06</u>	Setting Depth: <u>120</u> feet
Rated Pump Capacity: <u>27</u> Gallons Per Minute	Number of Stages: <u>11</u>

Pump Test Data	Method of Measuring Water Level Circle one
Date Well Tested: <u>8-3-06</u>	Air Line Electric Measuring Line Steel Tape
Static Water Level (A): <u>80'</u> Feet Below Land Surface	Other (specify): _____
Pumping Water Level (B): <u>~ 95</u> Feet Below Land Surface	For flowing well, measured shut in head: _____ feet
Drawdown [(B) - (A)]: <u>~ 15</u> Feet Below Land Surface	Well yielded _____ GPM with a drawdown of _____ feet after _____ hours of pumping
Test Pumping Rate: <u>36</u> Gallons Per Minute	
Duration of Pump Test (minimum 4 hours): <u>1</u> hours	

I HEREBY CERTIFY that the above statements are true to the best of my knowledge.

David S. Thomas 0-147
 Print Name of Pump Installer and License No. (if applicable)

[Signature]
 Signature of Pump Installer

Form: OLWR-SWR-1B

RECEIVED
 AUG 16 2006
 BY: OLWR