


N 2
5-23-62

WATER WELL DRILLERS LOG

CODED

Date: 5-23, 1962, Driller: THOMAS & SON County LEAKE
(Name)

	Description & Color of Materials Sand, Clay, Red Clay, Shell, etc.	Thick- ness Feet	Depth Feet
(1) Owner of Land: <u>J. M. Withers</u> (Name) <u>R.F. 3 Carthage, Miss</u> (Address)	Clay & Dry sand	80	0-80
(2) Location: <u>NW 1/4, NW 1/4, Sec. 11 T. 26 N. R. 3 E.</u>	White Chalk	20	100
<u>13</u> miles <u>S.W.</u> of <u>Carthage</u> (distance) (direction) (Nearest Town)	Sand	15	115
(3) Topography: <u>(Hilly)</u> (Flat) (Level)			
(4) Purpose of Well: <u>Domestic</u> (Domestic Irrigation Municipal, Industrial, Other)			
Information upon completion of well:			
(1) Diameter <u>2</u> inches.			
(2) Total Depth <u>115</u> feet.			
(3) Water Level <u>102</u> feet below top of ground.			
(4) Cased to <u>110</u> , Size <u>2</u>			
(5) Screen: Size <u>60</u> , Length <u>5 ft.</u>			
(6) Were any formations sealed against pollution?			
_____ yes, <u>✓</u> no.			
If YES depth of formation _____			
Why _____			
Drillers Remarks: _____			

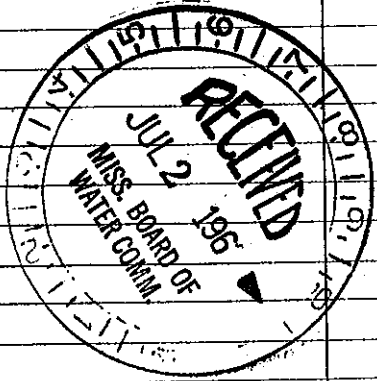

Well No.

(Use Back Side)