

LEAKE MISSISSIPPI BOARD OF WATER COMMISSIONERS

**N 4
4-5-63**

WATER WELL DRILLERS LOG

CODED


Date: 4-5, 1963, Driller: Hearon County Leake
(Name)

(1) Owner of Land: <u>Paul Crawford</u> (Name)	Description & Color of Materials Sand, Clay, Red Clay, Shell, etc.	Thick- ness Feet	Depth Feet
<u>Carthage, Miss</u> (Address)	<u>Yellow Clay</u>	<u>8</u>	<u>8</u>
<u>Good Hope Road</u> (Address)	<u>Green sand</u>	<u>2</u>	<u>10</u>
(2) Location: <u>1/4, 1/4, Sec. 33 T2 R6</u>	<u>white-yellow clay</u>	<u>10</u>	<u>20</u>
<u>4 miles N of Ludlow</u> (distance) (direction) (Nearest Town)	<u>white clay & sandstone</u>	<u>65</u>	<u>85</u>
(3) Topography: <u>Hilly</u> (Hilly) (Flat) (Level)	<u>Grey sand & clay mix</u>	<u>25</u>	<u>110</u>
(4) Purpose of Well: <u>Domestic</u> (Domestic Irrigation Municipal, Industrial, Other)	<u>Light Gray fine tuffe</u>	<u>18</u>	<u>128</u>
	<u>Grey clay</u>	<u>20</u>	<u>148</u>
	<u>Grey sand & pebbles</u>	<u>45</u>	<u>193</u>
	<u>Mix sand clay</u>	<u>20</u>	<u>213</u>
	<u>Grey sand</u>		<u>233 1/2</u>

Information upon completion of well:

- (1) Diameter 2 inches.
- (2) Total Depth 233 1/2 feet.
- (3) Water Level 57 feet below top of ground.
- (4) Cased to 228, Size 2"
- (5) Screen: Size 2 1/2", Length 5 ft
- (6) Were any formations sealed against pollution?
 yes, no.

If YES depth of formation _____
Why _____
Drillers Remarks: _____

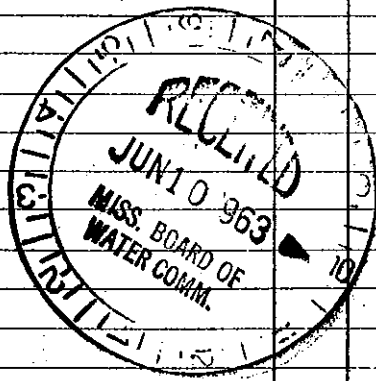

(Use Back Side)

Well No.