

Leake MISSISSIPPI BOARD OF WATER COMMISSIONERS

115

7-66

WATER WELL DRILLERS LOG

CODED

Date: 7-7, 1966, Driller: J P Thornton County Leake
 (Name)

(1) Owner of Land:	Description & Color of Materials Sand, Clay, Red Clay, Shell, etc.	Thick- ness Feet	Depth Feet
<u>Bobby Jupp</u> (Name)	<u>Yellow clay</u>	<u>25</u>	
<u>Walnut Grove Miss</u> (Address)	<u>dry sand</u>	<u>20</u>	
(2) Location: <u>SW 1/4, SE 1/4, Sec. 11 T. 9 R. 6</u>	<u>Pink chalk</u>	<u>10</u>	
<u>5 miles</u> <u>north</u> of <u>Leake</u>	<u>rock</u>	<u>3</u>	
(distance) (direction) (Nearest Town)	<u>Blue mud</u>	<u>25</u>	
(3) Topography: <u>X</u>	<u>rock</u>	<u>1</u>	<u>94</u>
(Hilly) (Flat) (Level)	<u>fine water sand</u>	<u>16</u>	
(4) Purpose of Well: <u>Domestic</u>			
(Domestic Irrigation Municipal, Industrial, Other)			


Information upon completion of well:

- (1) Diameter 2 inches.
- (2) Total Depth 100 feet.
- (3) Water Level 60 feet below top of ground.
- (4) Cased to 85', Size 2
- (5) Screen: Size 1 1/4 90 mesh Length 6 ft.
- (6) Were any formations sealed against pollution?
 _____ yes, no.

If YES depth of formation _____

Why _____

Drillers Remarks: 375' job B. hr.

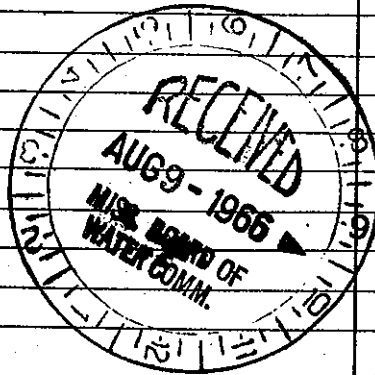

Well No. 102

(Use Back Side)

Mail this copy to Board of Water Commissioners 429 Miss. St. Jackson, Mis: