

Leake
N 6
8-66

MISSISSIPPI BOARD OF WATER COMMISSIONERS

CODED

WATER WELL DRILLERS LOG

Date: 8-31, 1966, Driller: J P Thornton County Leake
(When well drilled) (Name) (Where well is located)

		Description & Color of Materials Sand, Clay, Red Clay, Shell, etc.	Thick- ness Feet	Depth Feet
(1) Owner of Land: <u>Loren S. Donley</u> <small>(Name)</small>		<u>Red clay</u>	<u>29</u>	<u>29</u>
<u>Route 2 Box 30 Lena miss</u> <small>(Address)</small>		<u>Red sand</u>	<u>25</u>	<u>54</u>
(2) Location: <u>N 1/2 of S 1/2</u> <small>1/4, 1/4, Sec. 2 T9R6</small>		<u>Pink Chalk</u>	<u>1</u>	<u>55</u>
<u>4 1/2 miles N W of Lena miss</u> <small>(distance) (direction) (Nearest Town)</small>		<u>White water sand</u>	<u>30</u>	<u>85</u>
(3) Topography: <u>X</u> <small>(Hilly) (Flat) (Level)</small>				
(4) Purpose of Well: <u>Domestic</u> <small>(Domestic Irrigation Municipal, Industrial, Other)</small>				

Information upon completion of well:


- (1) Diameter 2 inches.
- (2) Total Depth 85 feet.
- (3) Water Level 65 feet below top of ground.
- (4) Cased to 80, Size 2"
- (5) Screen: Size 2", Length 5' 2"
- (6) Were any formations sealed against pollution?
 yes, no.

If YES depth of formation _____

Why _____

Drillers Remarks: _____

Yield in gpm: 5 gal per min
 Size pump: 1/2 H.P. R.P.D. Pump
 Type power: 110

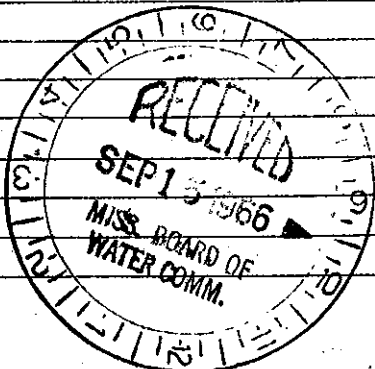

Retain this copy for your office files.