

LEAKE

MISSISSIPPI BOARD OF WATER COMMISSIONERS

CODED

WATER WELL DRILLERS LOG

Date: 6/14, 1965, Driller: M. Kay County: Madison


(1) Owner of Land: Hermon Walker (Name) Farmhouse (Address) (2) Location: 1/4, 96, 1/4, Sec. T. R. 7 miles E of Farmhouse (distance) (direction) (Nearest Town) (3) Topography: (Hilly) (Flat) (Level) (4) Purpose of Well: Home (Domestic Irrigation Municipal, Industrial, Other)

Table with 3 columns: Description & Color of Materials (Sand, Clay, Red Clay, Shell, etc.), Thickness (Feet), Depth (Feet). Rows include: Red Clay (0-20), Red Sand (20-40), Blue Clay (40-160), Sandy Clay (160-180), Sand (180-200), Blue Clay (200-340), Sand (340-380), Hard Shell (380-440), Sand (440-480), Sand (480-511).

Information upon completion of well:

(1) Diameter 8 1/2 inches. (2) Total Depth 511 feet. (3) Water Level 74 feet below top of ground. (4) Cased to, Size. (5) Screen: Size 007, Length 20. (6) Were any formations sealed against pollution? yes, no.

Air Compressor 591-592

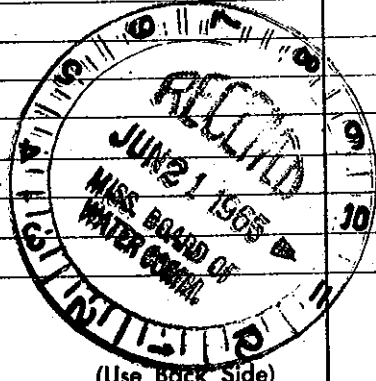

Well No.