

MISSISSIPPI BOARD OF WATER COMMISSIONERS

WATER WELL DRILLERS LOG

CODED

Leake
N-21
7-1-63

Date: 7-1, 1963, Driller: Hearson Drilling Co, County: Leake
(Name)

(1) Owner of Land: H. Stone
(Name)

(Address)

(2) Location: 1/4, 1/4, Sec. 32, T. 9 N.

miles _____ of _____
(distance) (direction) (Nearest Town)

(3) Topography: 1
(Hilly) (Flat) (Level)


(4) Purpose of Well: Domestic
(Domestic Irrigation, Municipal, Industrial, Other)

Description & Color of Materials Sand, Clay, Red Clay, Shell, etc.	Thick- ness Feet	Depth Feet
<u>Hard Clay</u>	<u>15</u>	<u>15</u>
<u>Beak clay</u>	<u>37</u>	<u>52</u>
<u>Rock</u>	<u>5</u>	<u>57</u>
<u>Beak clay</u>	<u>3</u>	<u>60</u>
<u>Rock</u>	<u>2</u>	<u>62</u>
<u>Beak clay</u>	<u>8</u>	<u>70</u>
<u>Rock</u>	<u>2</u>	<u>72</u>
<u>Beak clay</u>	<u>8</u>	<u>80</u>
<u>Gray clay</u>	<u>14</u>	<u>94</u>
<u>Layer of sand & gravel</u>	<u>96</u>	<u>190</u>
<u>Light Beak clay & Sand</u>	<u>60</u>	<u>250</u>
<u>Dark Gray sand</u>	<u>30</u>	<u>280</u>
<u>Coarse Gray sand</u>		<u>286</u>

Information upon completion of well:

(1) Diameter: 2 inches.
(2) Total Depth: 286 1/2 feet.
(3) Water Level: Level top of ground feet below top of ground.
(4) Cased to: 280, Size _____
(5) Screen: Size 2 1/2", Length 5
all 5" steel
(6) Were any formations sealed against pollution?
_____ yes, _____ no.

CODED

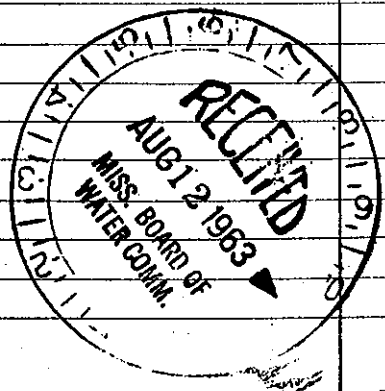

If YES depth of formation _____
Why _____
Drillers Remarks: This well produces 2250 gallons and has with this, it is an art well

(Use Back Side)

Mail this copy to Board of Water Commissioners 429 Miss. St. Jackson, Miss.