

LEAKE MISSISSIPPI BOARD OF WATER COMMISSIONERS

① 8
2-14-64

WATER WELL DRILLERS LOG

CODED

Date: 2-14-, 1964, Driller: Layne-Central Co. County Leake
(Name)

		Description & Color of Materials Sand, Clay, Red Clay, Shell, etc.	Thick- ness Feet	Depth Feet
(1) Owner of Land: <u>Lena Water Wks. Assn.</u> (Name)		R & W clay	20	20
<u>Lena, Mississippi</u> (Address)		brown sand	17	37
(2) Location: <u>1/4, 1/4, Sec. 33 T R</u> (distance) (direction) (Nearest Town)		white clay	18	55
(3) Topography: _____ (Hilly) (Flat) (Level)		sand-clay	40	95
(4) Purpose of Well: <u>municipal</u> (Domestic Irrigation, Municipal, Industrial, Other)		white sand	15	110
		clay-shale stks	38	148
		sand-shale stks	52	200
		hard shale	15	215
		clay	29	244
		sandy shale	66	310
		sand	10	320
		sand-clay stks	20	340
		sand	52	392


Information upon completion of well:

- (1) Diameter 6 inches.
- (2) Total Depth 392 feet.
- (3) Water Level 116' feet below top of ground.
- (4) Cased to 350', Size 6"
- (5) Screen: Size 4", Length 40'
- (6) Were any formations sealed against pollution?
X yes, _____ no.

If YES depth of formation 350'

Why required

Drillers Remarks: _____

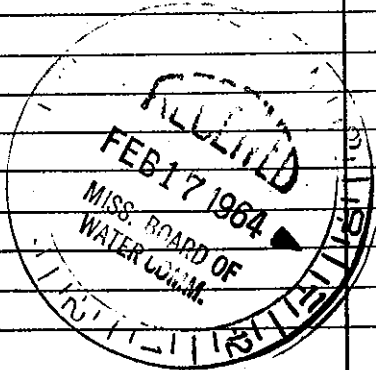

(Use Back Side)

Well No.

Mail this copy to Board of Water Commissioners 429 Miss. St. Jackson, Miss