

MISSISSIPPI BOARD OF WATER COMMISSIONERS

WATER WELL DRILLERS LOG

CODED

Leake
#10
8-66

Date: 8-10, 1966, Driller: Henson Greig County: Leake
(Name)

(1) Owner of Land <i>Bill Morgan</i> (Name)	Description & Color of Materials Sand, Clay, Red Clay, Shell, etc.	Thick- ness Feet	Depth Feet
<i>R 4 Cart Lager, Miss</i> (Address)	<i>Clay</i>	<i>0</i>	<i>20</i>
(2) Location: <i>NW 1/4, NW 1/4, Sec. 25 T 9 R 7</i>	<i>Very hard</i>	<i>65</i>	<i>85</i>
<i>1 1/2</i> miles <i>S 7/8</i> of <i>Carters</i> (distance) (direction) (Nearest Town)	<i>Clay</i>	<i>65</i>	<i>150</i>
(3) Topography: <input checked="" type="checkbox"/> (Hilly) <input type="checkbox"/> (Flat) <input type="checkbox"/> (Level)	<i>Dark sand</i>	<i>70</i>	<i>160</i>
(4) Purpose of Well: <i>Domestic</i> (Domestic Irrigation Municipal, Industrial, Other)	<i>Red-Sand + Clay</i>	<i>40</i>	<i>200</i>
	<i>Very dark sand</i>	<i>40</i>	<i>240</i>
	<i>Water sand (grey)</i>	<i>14</i>	<i>254</i>

Information upon completion of well:


- (1) Diameter 2 inches.
- (2) Total Depth 253 feet.
- (3) Water Level 152 feet below top of ground.
- (4) Cased to 248, Size 2"
- (5) Screen: Size 2 1/2 x 5', Length 5
- (6) Were any formations sealed against pollution?
 yes, no.

If YES depth of formation _____

Why _____

Drillers Remarks: Consistent

Failed around casing at top

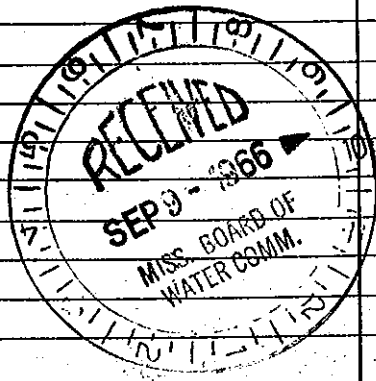

Well No.

(Use Back Side)