

LEAKE MISSISSIPPI BOARD OF WATER COMMISSIONERS


11
4-18-61

WATER WELL DRILLERS LOG

CODED

Date: 4-18, 1961, Driller: J P Thornton County Leake
(Name)

	Description & Color of Materials Sand, Clay, Red Clay, Shell, etc.	Thick- ness Feet	Depth Feet
(1) Owner of Land: <u>Bill Johnston</u> (Name) <u>Lena Miss</u> (Address)	<u>Clay + sand</u>	<u>60</u>	<u>60</u>
(2) Location: <u>17 97</u> 1/4, 1/4, Sec. T. R. <u>2 1/2 miles North East of Lena</u> (distance) (direction) (Nearest Town)	<u>Black dirt</u> <small>cmf</small>	<u>115</u>	<u>175</u>
(3) Topography: <u>Hilly</u> (Hilly) (Flat) (Level)	<u>Chalk + sand</u>	<u>20</u>	<u>195</u>
(4) Purpose of Well: <u>Domestic</u> (Domestic Irrigation Municipal, Industrial, Other)	<u>Gray sand</u>	<u>47</u>	<u>242</u>
<p>Information upon completion of well:</p> <p>(1) Diameter <u>2</u> inches.</p> <p>(2) Total Depth <u>242</u> feet.</p> <p>(3) Water Level <u>105'</u> feet below top of ground.</p> <p>(4) Cased to <u>235</u>, Size <u>2"</u></p> <p>(5) Screen: Size <u>1 1/4</u>, Length <u>6 ft 8"</u></p> <p>(6) Were any formations sealed against pollution? _____ yes, <u>X</u> no.</p> <p>If YES depth of formation _____</p> <p>Why _____</p> <p>Drillers Remarks: <u>250 gal Per hour</u></p>	<p>5438</p>		

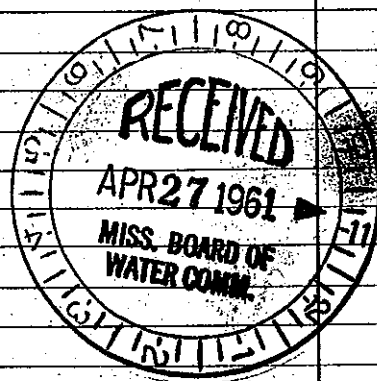

Well No.

(Use Back Side)

Retain this copy for your office files.