

**LEAKE MISSISSIPPI BOARD OF WATER COMMISSIONERS**

013  
11-24-61

**WATER WELL DRILLERS LOG**

0 CODED

Date: 11-24, 1961, Driller: Hearon Drilling County Leake  
5 (Name)

(1) Owner of Land: Willie Collier  
(Name)  
Rt 1 Leake  
(Address)  
(2) Location:  $\frac{1}{4}$ , 23 9 7 Sec. T R  
1 miles W of Tuscola  
(distance) (direction) (Nearest Town)  
(3) Topography: Hilly  
(Hilly) (Flat) (Level)  
(4) Purpose of Well: Domestic  
(Domestic Irrigation  
Municipal, Industrial, Other)


Description & Color of Materials Sand, Clay, Red Clay, Shell, etc.	Thick- ness Feet	Depth Feet
<u>Red clay</u>	<u>20</u>	<u>20</u>
<u>Red Sand clay</u>	<u>30</u>	<u>50</u>
<u>Dark Grey clay</u>	<u>100</u>	<u>150</u>
<u>Dark Grey silt sand</u>	<u>60</u>	<u>210</u>
<u>Light to medium Grey sand</u>	<u>35</u>	<u>245</u>

2582

**Information upon completion of well:**

(1) Diameter 2 inches.  
(2) Total Depth 245 feet.  
(3) Water Level 126 ft feet below top of ground.  
(4) Cased to 238, Size 2"  
(5) Screen: Size 1 1/4", Length 6 ft  
(6) Were any formations sealed against pollution?  
yes,  no.

If YES depth of formation \_\_\_\_\_  
Why \_\_\_\_\_  
Drillers Remarks: \_\_\_\_\_

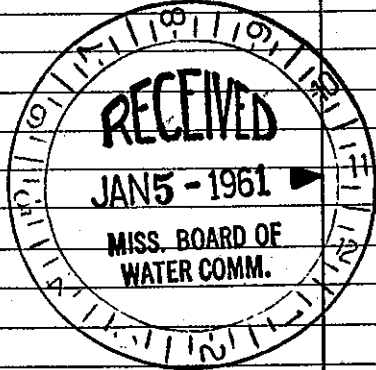

Well No.

(Use Back Side)

Mail this copy to Board of Water Commissioners 429 Miss. St. Jackson, Miss.