

LEAKE
14
6-30-62

MISSISSIPPI BOARD OF WATER COMMISSIONERS

WATER WELL DRILLERS LOG

CODED

Date: 6-30, 1962, Driller: J P Thornton County Leake
(Name)

(1) Owner of Land:	Description & Color of Materials Sand, Clay, Red Clay, Shell, etc.	Thick- ness Feet	Depth Feet
H S Hardeman (Name)	red clay	50	
Senas miss (Address)	sand + chalk	20	
(2) Location: 1/4, 6 9 7, Sec. T R	shell rock	1	
North 3 1/2 miles, of Senas (distance) (direction) (Nearest Town)	white water sand	21	
(3) Topography: Hilly (Hilly) (Flat) (Level)			92
(4) Purpose of Well: Domestic (Domestic Irrigation Municipal, Industrial, Other)	1585		


Information upon completion of well:

- (1) Diameter 2 inches.
- (2) Total Depth 92 feet.
- (3) Water Level 60 feet below top of ground.
- (4) Cased to 85', Size 2"
- (5) Screen: Size 1 1/4, Length 6 ft
- (6) Were any formations sealed against pollution?
yes, no.

If YES depth of formation _____

Why _____

Drillers Remarks: 2 25 gal per hr

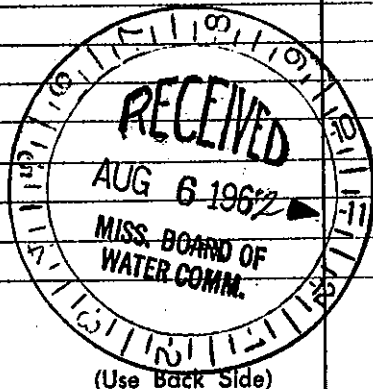

Well No.

Mail this copy to Board of Water Commissioners 429 Miss. St. Jackson, Mis