

MISSISSIPPI BOARD OF WATER COMMISSIONERS

LEAKE

017

10-9-62

WATER WELL DRILLERS LOG

CODED

Date 10-9, 1962, Driller Harold Dyer County Leake

(Name)

(1) Owner of Land	Description & Color of Materials Sand, Clay, Red Clay, Shell, etc.	Thick- ness Feet	Depth Feet
<u>Med Eey</u>	<u>Hard Clay</u>	<u>20</u>	<u>20</u>
(Name)			
<u>Lucia Meis</u>	<u>Red Dirt</u>	<u>40</u>	<u>60</u>
(Address)			
(2) Location: <u>1/4</u> , <u>1/4</u> , Sec. <u>2397</u>	<u>Red</u>	<u>5</u>	<u>65</u>
_____ T. R.			
<u>6</u> miles <u>E</u> of <u>Lucia</u>	<u>Red Dirt</u>	<u>5</u>	<u>70</u>
(distance) (direction) (Nearest Town)			
(3) Topography: <u>✓</u>	<u>Red</u>	<u>5</u>	<u>75</u>
(Hilly) (Flat) (Level)			
(4) Purpose of Well: <u>Domestic</u>	<u>Dark Sand</u>	<u>15</u>	<u>90</u>
(Domestic Irrigation Municipal, Industrial, Other)			
	<u>Shale</u>	<u>10</u>	<u>100</u>
	<u>Shale + Sand</u>	<u>30</u>	<u>130</u>
	<u>Dark Sand</u>	<u>10</u>	<u>140</u>
	<u>Shale + Sand</u>	<u>40</u>	<u>180</u>
	<u>Coarse Grey Sand</u>	<u>32</u>	<u>212</u>


Information upon completion of well:

- (1) Diameter 2 inches.
- (2) Total Depth 212 feet.
- (3) Water Level 59 feet below top of ground.
- (4) Cased to _____, Size _____.
- (5) Screen: Size 1/4 x, Length 6'.
- (6) Were any formations sealed against pollution?
_____ yes, _____ no.

If YES depth of formation _____

Why _____

Drillers Remarks: _____

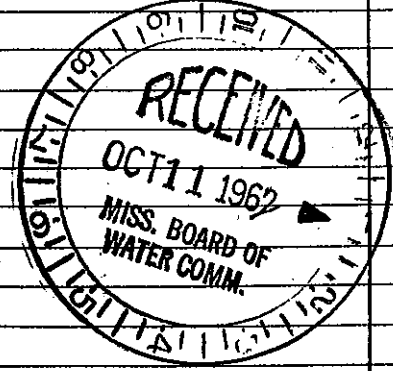

(Use Back Side)

Well No. _____

Mail this copy to Board of Water Commissioners 429 Miss. St. Jackson, Miss.