

Leake
018 CODED
8-68

MISSISSIPPI
 BOARD OF WATER COMMISSIONERS
 416 North State Street
 Jackson, Mississippi 39201

WATER WELL DRILLERS LOG

8-14-68 19 19 P.S.D. Drillers Leake?
 date well completed firm name county well located


LANDOWNER	description of formations encountered	from	to
<u>Mildred Bahl</u>			
<u>Leane Miss</u>			
<u>R. L. & I. Leane Miss</u> (mailing address)	<u>Red sand</u>	<u>0</u>	<u>10</u>
	<u>light Red sand</u>	<u>20</u>	<u>40</u>
	<u>White sand</u>	<u>41</u>	<u>67</u>

WELL LOCATION:
 sec. 7 T N R 9 E
6 miles SW of Leane
 (distance) (direction) (nearest town)

WELL PURPOSE: Home
 (home, irrigation, municipal, industrial)

WELL COMPLETION DATA:
 (1) diameter (inches) 3 1/2
 (2) total depth (feet) 67
 (3) static water level (feet) 34 below above top of ground.
 (4) casing 2" 63'
 (material) (depth)
 (size) If telescope see back.
 (5) screen 1/2" x 1/4" (depth to top)
 (length)
2" Aluminum
 (size) (material)
 (6) pump 1/2 (HP) (yield gpm)
Electric
 (type power)
 (7) electric log No
 (yes or no)
 (organization running log)
 (8) how well bottom plugged culpa plug

CODED

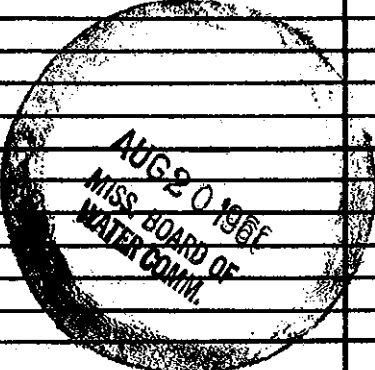

DRILLERS REMARKS: