

County: Leake 079
 Permit #: _____
 Driller: Thomas Drilling
 Date drilling completed: 2-17-05

Well Driller Report and Well Log

Mississippi Department of Environmental Quality
 Office of Land and Water Resources
 P.O. Box 10631
 Jackson, MS 39289-0631
 (601)961-5210
 (601)354-6938 (fax)

For Office Use Only:
 Aquifer: _____
 Well #: Ø 51
 L. S. Elevation: _____
 E-log #: _____

Thomas Drilling and Supply Company

State Law requires that this report be prepared by the driller in detail and filed with the Department within 30 days of completion of drilling of the well.

Well Owner Information	Well Location
Owner Name <u>CARLTON JENKINS</u>	Latitude: <u>32° 36.772'</u> Longitude: <u>89° 34.551'</u>
Mailing Address: _____	Method of Lat/Long (circle one): Conventional Survey, _____
_____	USGS quad, Hand-held GPS, Survey-grade GPS
City _____ State _____ Zip Code _____	<u>Grid 0</u> NE ¼ SE ¼ Sec <u>28</u> Twn <u>9N</u> Rng <u>7E</u>
Telephone No. () _____	Distance <u>.01</u> Miles <u>East</u> of <u>LENA</u>

Well Data

Purpose of Well (circle one) Home Industrial Public Supply Irrigation Fish Culture Other: _____

Date well drilling started: 2-17-05 Date well drilling completed: 2-17-05

If flowing, method of flow regulation: Valve _____ Other (describe) _____

Static Water Level: 42' feet above or below (circle one) land surface Date measured: _____

Method of Measurement (circle one) steel tape electric tape air line other: Drop pipe

Hole depth: 102' Well depth: 102' Well grouted to a depth of 10 feet

Type of grout (circle one): Cement Bentonite Mix

Casing length: 99 feet Casing diameter: 2 inches Type of casing: PVC

Screen length: 5 feet Screen diameter: 2 inches Type of screen: PVC

Screen slot size: .010 inches Setting depth: From 99 feet to 102 feet

Type of completion (circle all applicable): Gravel packed Underreamed Telescoped Open hole Natural Development

Other (describe): _____

Top of lap pipe or reduction in casing: _____ feet. If telescoped or more than one screen, describe on back of page

Logs run (circle all applicable): No log run Electric Gamma Ray Density Sonic Neutron Other: _____

Name of organization running log(s): _____

I certify that the well was drilled, constructed, and completed in accordance with all applicable requirements of the Mississippi Department of Environmental Quality and/or the Mississippi Department of Health regulations and state laws.

David S. Thomas 0-147
 Print Name of Water Well Contractor and License No.

[Signature]
 Signature of Water Well Contractor
RECEIVED
MAR 21 2005

If well telescopes please sketch below and show depths.

BY: OLWR

Ø51

Ground Level


Description of Formations Encountered

From To

Mixed Dirt	0	4
Red Sand	4	36
Yellow Sand	36	60
White Sand	60	102

If more than one screen, show location of each on sketch

Sketch the property layout and include the following: 1) the well location; 2) any permanent structures on the property that may aid in locating the well; 3) any roads, power lines, or other items that may aid in locating the property and the well; 4) indicate direction.

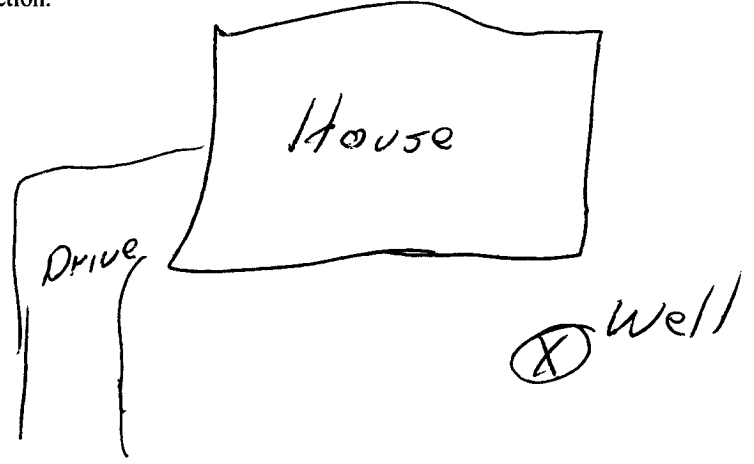

Landowner Name: CANTON JENKINE

Paul B. Thomas
Signature of Water Well Contractor

RECEIVED
MAR 21 2005
BY: OLWR

STATE WELL REPORT

Part 2

Pump Installer's Completion Report

County: LEAKE
 Permit #: _____
 Driller: THOMAS Drilling
 Date completed: 2-17-05

Mississippi Department of Environmental Quality
 Office of Land and Water Resources
 P.O. Box 10631
 Jackson, MS 39289-0631
 (601)961-5210
 (601)354-6938 (fax)

For Office Use Only:

Aquifer: _____
 Well #: Ø 51
 Elevation: _____

This report must be prepared by the pump installer in detail and filed with the Department within 30 days of the installation of pump. A copy of Part 1 of this report must be attached to this report.

Well Owner Information	Well Location
Owner Name: <u>CARLTON JENKINS</u>	Latitude: <u>N 32° 36.772'</u> Longitude: <u>W 089° 34.551'</u>
Mailing Address: _____	Method of Lat/Long (circle one): Conventional Survey,
_____	<u>Grid 0</u> USGS quad, Hand-held GPS, Survey-grade GPS
City _____ State _____ Zip Code _____	_____ ¼ _____ ¼ Sec <u>28</u> Twn <u>9N</u> Rng <u>7E</u>
Telephone No. (____) _____	Distance _____ Direction _____ Nearest Town _____
	<u>.01</u> Miles <u>EAST</u> of <u>LENA</u>

Pump Type Circle one	Power Type Circle one
Air Lift <input checked="" type="radio"/> <u>Jet</u> <input type="radio"/> Submersible	Diesel Engine <input type="radio"/> Gasoline Engine <input type="radio"/> Natural Gas <input type="radio"/>
Bucket <input type="radio"/> Piston <input type="radio"/> Turbine	<input checked="" type="radio"/> <u>Electric Motor</u> <input type="radio"/> Hand <input type="radio"/> Tractor PTO
Centrifugal <input type="radio"/> Rotary <input type="radio"/> Flowing Well	Windmill <input type="radio"/> Other (specify): _____
Other (specify): _____	Horse Power Rating of Motor: <u>1</u>
Date Pump Installed: <u>2-17-05</u>	Setting Depth: <u>60</u> feet
Rated Pump Capacity: <u>10</u> Gallons Per Minute	Number of Stages: <u>2</u>

Pump Test Data	Method of Measuring Water Level Circle one
Date Well Tested: <u>2-17-05</u>	Air Line <input type="radio"/> Electric Measuring Line <input type="radio"/> Steel Tape <input type="radio"/>
Static Water Level (A): _____ Feet Below Land Surface	Other (specify): _____
Pumping Water Level (B): <u>N/A</u> Feet Below Land Surface	For flowing well, measured shut in head: _____ feet
Drawdown [(B) - (A)]: _____ Feet Below Land Surface	Well yielded _____ GPM with a drawdown of _____ feet after _____ hours of pumping
Test Pumping Rate: <u>10</u> Gallons Per Minute	
Duration of Pump Test (minimum 4 hours): <u>1</u> hours	

I HEREBY CERTIFY that the above statements are true to the best of my knowledge.

David S. Thomas 0-147 [Signature]
 Print Name of Pump Installer and License No. (if applicable) Signature of Pump Installer

RECEIVED
 MAR 21 2005
BY: OLWR