

County: Leake
 Permit #: _____
 Driller: Thomas Drilling
 Date drilling completed: 12-26-06

State Well Report
Part 1 - Driller's Log
 Mississippi Department of Environmental Quality
 Office of Land and Water Resources
 P.O. Box 10631
 Jackson, MS 39289-0631
 (601)961-5210
 (601)354-6938 (fax)

For Office Use Only:
 Aquifer: _____
 Well #: Q-58
 L. S. Elevation: _____
 E-log #: _____

State Law requires that this report be prepared by the license holder responsible for the work and filed with the Department at the above address within 30 days of completion of drilling of the well or borehole.

Information on Well Owner (Landowner if borehole is not for a water well)	Well or Borehole Location
Owner Name: <u>Andy Shannon #1</u>	Latitude: <u>32° 36.846'</u> Longitude: <u>89° 35.242'</u>
Mailing Address: <u>6800 Utah Rd</u>	Method of Lat/Long (circle one): <u>Conventional Survey</u>
<u>LENA</u> <u>MS</u> <u>39094</u>	USGS quad, <u>Hand-held GPS</u> , Survey-grade GPS
City State Zip Code	<u>SE 1/4 NW 1/4 Sec 21 Twn 9N Rng 2E</u>
Telephone No. () _____	Distance <u>3/4</u> Miles Direction <u>N</u> of Nearest Town <u>LENA</u>
Well / Borehole Data	
Date drilling started: <u>12-26-06</u> Date drilling completed: <u>12-26-06</u> Hole depth: <u>80'</u> Hole diameter: <u>4"</u>	
Location of the source of any surface water used for drilling: <u>Thomas Drilling</u>	
Method of dosing and volume of Chlorine used in drilling and development: <u>1lb in tender & wash</u>	
Logs run (circle all applicable): <u>No logs</u> Electric Gamma Ray Density Sonic Neutron Other: _____	
Name of organization running log(s): _____	
Purpose of borehole (check one): Water Well <input checked="" type="checkbox"/> Geotechnical/Geological Investigation _____ Ground Source Heat Pump _____	
Seismic Survey _____ Other (describe) _____	
<i>If drilling is not related to water well construction, skip the remainder of this block</i>	
Purpose of Well (check one): Home _____ Industrial _____ Public Supply _____ Irrigation _____ Fish Culture _____ Other: <u>Poultry</u>	
If a flowing well, method of flow regulation: Valve _____ Other (describe) _____	
Static Water Level: <u>14</u> feet above or below (circle one) land surface Date measured: <u>12-26-06</u>	
Method of Measurement (circle one) steel tape electric tape <u>air line</u> other: _____	
Well depth: <u>60</u> Well grouted to a depth of <u>10</u> feet Type of grout (circle one): <u>Neat Cement</u> Bentonite Mix	
Casing length: <u>60</u> feet Casing diameter: <u>4</u> inches Type of casing: <u>PVC</u>	
Screen length: <u>20</u> feet Screen diameter: <u>4</u> inches Type of screen: <u>PVC</u>	
Screen slot size: <u>.010</u> inches Setting depth: From <u>60</u> feet to <u>80</u> feet	
Type of completion (circle all applicable): <u>Gravel packed</u> Underreamed Telescoped Open hole Natural Development	
Other (describe): _____	
Top of lap pipe or reduction in casing: _____ feet <i>If telescoped or more than one screen, describe on next page</i>	


Form: OLWR-SWR-1A
RECEIVED
 JAN 05 2007
 BY: OLWF

Q-58

The sketch below only required for water wells

If well telescopes, show depth on sketch.

Ground Level 

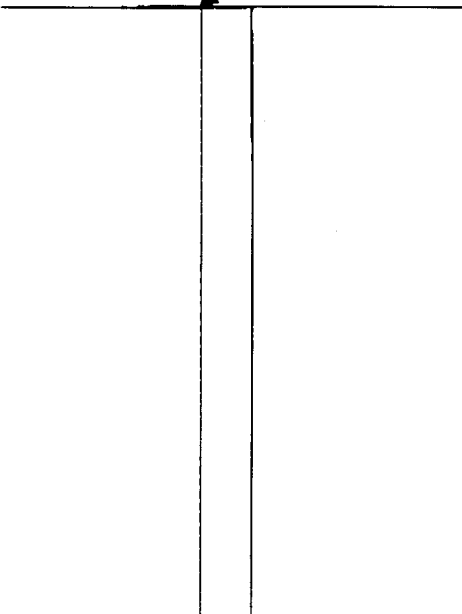

Description of formations encountered must be provided for all wells and boreholes, unless specifically exempted by regulations

Description of Formations Encountered	From (depth) To (depth)	
	Ground Level	
Mixed Clay	0	18
Fine White Sand	18	65
Med. Fine White Sand	65	80

If more than one screen, show location of each on sketch


Sketch the property layout and include the following: 1) the well location; 2) any permanent structures on the property that may aid in locating the well; 3) any roads, power lines, or other items that may aid in locating the property and the well; 4) a north arrow.

Landowner Name: Andy SHANNON

Form: OLWR-SWR-1A

I certify that the well/borehole was drilled, constructed, and completed in accordance with all applicable requirements of the Mississippi Department of Environmental Quality and the Mississippi Department of Health regulations, if applicable, and state laws.

James E Thomas 702 12/26/06
 Print Name of Responsible Licensee and License No. Date

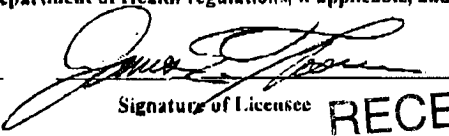
 Signature of Licensee

RECEIVED
 JAN 05 2007
 BY: OLWF

STATE WELL REPORT

Part 2

Pump Installer's Completion Report
 Mississippi Department of Environmental Quality
 Office of Land and Water Resources
 P.O. Box 10631
 Jackson, MS 39289-0631
 (601)961-5210
 (601)354-6938 (fax)

County: Leake
 Permit # _____
 Driller: THOMAS Drilling
 Date completed: 12-29-06
 Copy information from block on Part 1

For Office Use Only:

Aquifer: _____
 Well #: Q-58
 Elevation: _____

This part of the report must be completed by a licensed water well contractor or a licensed pump installer. A copy of Part 1 of the report must be attached and both parts filed with the Department at the above address within 30 days of well completion.

Well Owner Information	Well Location
Owner Name: <u>ANDY SHANNON #1</u>	Latitude: <u>32°36.846</u> Longitude: <u>89°35.242</u>
Mailing Address: <u>6800 Utah Rd</u>	Method of Lat/Long (check one): Conventional Survey _____
<u>LENA</u> <u>MS</u> <u>39094</u> City State Zip Code	USGS quad _____ Hand-held GPS <input checked="" type="checkbox"/> Survey-grade GPS _____
Telephone No. (_____) _____	_____ 1/4 _____ 1/4 Sec <u>21</u> T <u>9N</u> R <u>7E</u>
	Distance _____ Direction _____ Nearest Town _____
	<u>3/4</u> Miles <u>N</u> of <u>LENA</u>

	Pump Type Circle one	Power Type Circle one
Air Lift	Jet <input type="checkbox"/> <u>Submersible</u>	Diesel Engine <input type="checkbox"/> Gasoline Engine <input type="checkbox"/> Natural Gas <input type="checkbox"/>
Bucket	Piston <input type="checkbox"/> Turbine <input type="checkbox"/>	<u>Electric Motor</u> <input type="checkbox"/> Hand <input type="checkbox"/> Tractor PTO <input type="checkbox"/>
Centrifugal	Rotary <input type="checkbox"/> Flowing Well <input type="checkbox"/>	Windmill <input type="checkbox"/> Other (specify): _____
Other (specify): _____		Horse Power Rating of Motor: <u>1 1/2</u>
Date Pump Installed: <u>12-29</u>		Setting Depth: <u>40</u> feet
Rated Pump Capacity: <u>27</u> Gallons Per Minute		Number of Stages: <u>9</u>

Pump Test Data	Method of Measuring Water Level Circle one
Date Well Tested: <u>12-29-06</u>	Air Line <input type="checkbox"/> Electric Measuring Line <input type="checkbox"/> Steel Tape <input type="checkbox"/>
Static Water Level (A): <u>14</u> Feet Below Land Surface	Other (specify): _____
Pumping Water Level (B): <u>15</u> Feet Below Land Surface	For flowing well, measured shut in head: _____ feet
Drawdown [(B) - (A)]: <u>1</u> Feet Below Land Surface	Well yielded _____ GPM with a drawdown of _____ feet after _____ hours of pumping
Test Pumping Rate: <u>30</u> Gallons Per Minute	
Duration of Pump Test (minimum 4 hours): <u>1</u> hours	

I HEREBY CERTIFY that the above statements are true to the best of my knowledge.

James E. Thomas 902
 Print Name of Pump Installer and License No. (if applicable)

[Signature]
 Signature of Pump Installer

RECEIVED

JAN 05 2007

BY: OLWR