

LEAKE

BOARD OF WATER COMMISSIONERS

WATER WELL DRILLERS LOG


OPD CODED
w/ Leake

P/1
5-15-61
245
207
308
286
242
40

Date: May 15, 1961, Driller: Robert E. Ruffell County Linn

(Name)

(1) Owner of Land:	Description & Color of Materials <small>Sand, Clay, Red Clay, Shell, etc.</small>	Thick- ness Feet	Depth Feet
<u>Town of Walnut Grove</u> (Name) <u>Walnut Grove, Miss.</u> (Address)	Clay	0	21
(2) Location: <u>1/4</u> , <u>1/4</u> , Sec. <u>34</u> T <u> </u> R <u> </u>	Sand	21	35
_____ miles _____ of _____ (distance) (direction) (Nearest Town)	Lignite	35	36
(3) Topography: _____ (Hilly) (Flat) (Level)	Sand	36	210
(4) Purpose of Well: <u>Municipal</u> (Domestic Irrigation, Municipal, Industrial, Other)	Sandy shale	210	245
Information upon completion of well:	Shale	245	307
(1) Diameter <u>6</u> inches.	Rock	307	307
(2) Total Depth <u>368</u> feet.	Sand	307	318
(3) Water Level _____ feet below top of ground.	Rock	308	318
(4) Cased to _____, Size _____	Sandy sand	318	319
(5) Screen: Size <u>4"</u> , Length <u>318'-368'</u>	Sandy shale, rock	319	380
(6) Were any formations sealed against pollution? _____ yes, _____ no.	White sand	380	390
If YES depth of formation _____	Shale	613	613
Why _____	Shale	613	616
Drillers Remarks: _____	w. sand log	616	652
_____	Shell	652	654
_____	Entropy?	654	686
_____	Shale	686	746
_____	Chucks with Electric log. w. H. Hinton		

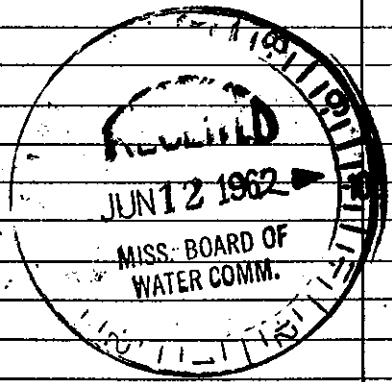

Well No.

(Use Back Side)

Retain this copy for your office files.