

P 7

CODED

4-30-62

WATER WELL DRILLERS LOG

Date: 4-30, 1962, Driller: Harold Oriley County: Leake
 (Name)

(1) Owner of Land: John Sanders
 (Name)
Carthage Miss
 (Address)
 (2) Location: 1/4, 1/4, Sec 6 9N 8E
 T R
6 miles S of Carthage
 (distance) (direction) (Nearest town)
 (3) Topography: Hilly
 (Hilly) (Flat) (Level)
 (4) Purpose of Well: Domestic
 (Domestic Irrigation
 Municipal, Industrial, Other)

Description & Color of Materials Sand, Clay, Red Clay, Shell, etc.	Thick- ness Feet	Depth Feet
<u>Red clay</u>	<u>6</u>	
<u>Hard formation</u>	<u>24</u>	<u>30</u>
<u>medium hardness</u>	<u>20</u>	<u>50</u>
<u>Shale & sand</u>	<u>40</u>	<u>90</u>
<u>Light gray</u>	<u>40</u>	<u>130</u>
<u>"drilled like sand"</u>	<u>127</u>	<u>257</u>


See note on back

Information upon completion of well:

(1) Diameter 2 inches.
 (2) Total Depth 257 feet.
 (3) Water Level 87 feet below top of ground.
 (4) Cased to _____, Size _____
 (5) Screen: Size 2 1/4, Length 5
all S, steel
 (6) Were any formations sealed against pollution?
 _____ yes, _____ no.

If YES depth of formation _____
 Why _____
 Drillers Remarks: Air compressor
job

See note on back

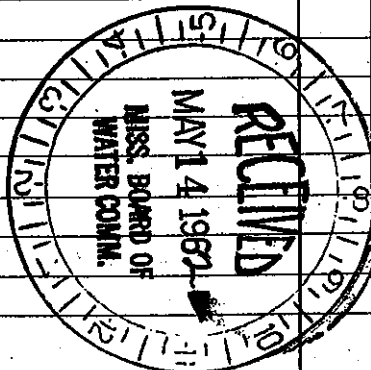

Well No.

(Use Back Side)