

LEAKE MISSISSIPPI BOARD OF WATER COMMISSIONERS


P8
8-16-62

WATER WELL DRILLERS LOG

CODED

Date: 8-16, 1962, Driller: Sharon Driggs & Sons & County Leake
(Name)

(1) Owner of Land	Description & Color of Materials Sand, Clay, Red Clay, Shell, etc.	Thick- ness Feet	Depth Feet
<u>Opas Ware</u> (Name) <u>Walnut Grove, Miss</u> (Address)	<u>Clay</u>	<u>25</u>	<u>25</u>
(2) Location: <u>22</u> <u>9</u> <u>8</u> <u>1/4</u> , <u>1/4</u> , Sec. <u>T</u> <u>R</u>	<u>Sand & Clay</u>	<u>30</u>	<u>55</u>
<u>1</u> miles <u>North</u> , of <u>Walnut Grove</u> (distance) (direction) (Nearest Town)	<u>Dark sand & clay</u>	<u>30</u>	<u>85</u>
(3) Topography: <u>Level</u> (Hilly) (Flat) (Level)	<u>Water Sand (Gravel)</u>	<u>12</u>	<u>97</u>
(4) Purpose of Well: <u>Domestic</u> (Domestic Irrigation Municipal, Industrial, Other)			
Information upon completion of well:			
(1) Diameter <u>2</u> inches.			
(2) Total Depth <u>97</u> feet.			
(3) Water Level <u>52</u> feet below top of ground.			
(4) Cased to _____, Size _____			
(5) Screen: Size <u>1/4</u> , Length <u>6</u>			
(6) Were any formations sealed against pollution? _____ yes, _____ no.			
If YES depth of formation _____			
Why _____			
Drillers Remarks: _____			

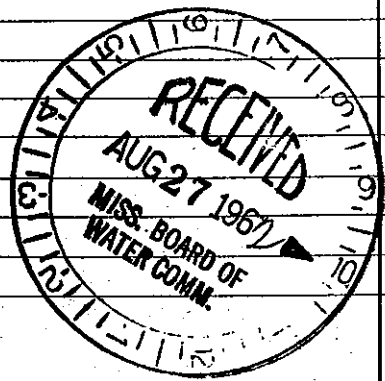

(Use Back Side)

Well No.

Mail this copy to Board of Water Commissioners 429 Miss. St. Jackson, Miss