

LEAKE
 1 P 13
 9-20-60


MISSISSIPPI BOARD OF WATER COMMISSIONERS

WATER WELL DRILLERS LOG

CODED

Date: Sept 20, 1960, Driller: Hearon County Leake
 (Name)

(1) Owner of Land: <u>Smythe Young</u> (Name)	Description & Color of Materials Sand, Clay, Red Clay, Shell, etc.	Thick- ness Feet	Depth Feet
<u>Rt 4 Carthage</u> (Address)	<u>clay Red</u>	<u>5</u>	<u>5</u>
(2) Location: <u>1/4, 1/4, Sec. T R</u>	<u>clay white</u>	<u>4</u>	<u>9</u>
<u>6 9 8</u> <u>6</u> miles <u>S</u> of <u>Carthage</u> (distance) (direction) (Nearest Town)	<u>Soap Stone</u>	<u>1</u>	<u>10</u>
(3) Topography: <u>Hilly</u> (Hilly) (Flat) (Level)	<u>Yellow Clay</u>	<u>3</u>	<u>13</u>
(4) Purpose of Well: <u>Domestic</u> (Domestic Irrigation Municipal, Industrial, Other)	<u>clay white</u>	<u>16</u>	<u>16</u>
<u>W.L.</u>	<u>clay yellow</u>	<u>5</u>	<u>21</u>
Information upon completion of well:	<u>clay white</u>	<u>2</u>	<u>23</u>
(1) Diameter <u>2</u> inches.	<u>clay white</u>	<u>2</u>	<u>25</u>
(2) Total Depth _____ feet.	<u>Sand white</u>	<u>10</u>	<u>35</u>
(3) Water Level _____ feet below top of ground.	<u>Soap Stone</u>	<u>15</u>	<u>50</u>
(4) Cased to _____, Size _____	<u>Sand Clay white</u>	<u>40</u>	<u>90</u>
(5) Screen: Size <u>2"</u> , Length <u>10 ft.</u>	<u>Sand white Pepper</u>	<u>40</u>	<u>130</u>
(6) Were any formations sealed against pollution? _____ yes, _____ no.	<u>Sand Blue Grey</u>	<u>10</u>	<u>140</u>
If YES depth of formation _____	<u>Sand Grey Pepper</u>	<u>73</u>	<u>213</u>
Why _____	<u>Sand Dark Grey Pepper</u>	<u>9</u>	<u>222</u>
Drillers Remarks: _____	<u>Sand Tan Pepper</u>	<u>23</u>	<u>245</u>
_____	<u>Blue clay</u>		

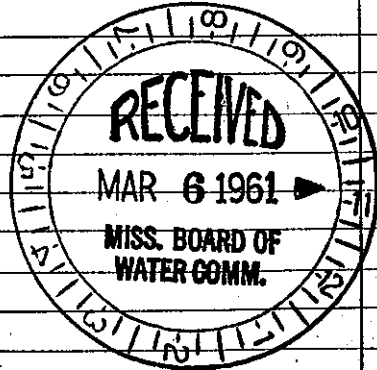

(Use Back Side)

Well No.