

LEAKE MISSISSIPPI BOARD OF WATER COMMISSIONERS

P15 WATER WELL DRILLERS LOG
2-26-61

CODED

Date: 2-26, 1961, Driller: J.P. Thornton County Leake
 (Name)

(1) Owner of Land: Archie Pigg
 (Name)
Carthage miss
TUSCOTA (Address) Road 98
 (2) Location: 1/4, 1/4 Sec. 98 T. R.
1/4 miles South of Carthage
 (distance) (direction) (Nearest Town)
 (3) Topography: Hilly
 (Hilly) (Flat) (Level)
 (4) Purpose of Well: Domestic
 (Domestic Irrigation
 Municipal, Industrial, Other)


Description & Color of Materials Sand, Clay, Red Clay, Shell, etc.	Thick- ness Feet	Depth Feet
<u>red clay</u>	<u>30</u>	<u>27</u>
<u>dry sand</u>	<u>35</u>	<u>27-65</u>
<u>white chert</u>	<u>4</u>	<u>27-69</u>
<u>shallow strata water sand</u>	<u>5</u>	<u>27-74</u>
<u>chert + sand mixed</u>	<u>40</u>	<u>27-114</u>
<u>white water sand</u>	<u>31</u>	<u>27-145</u>

1867

Information upon completion of well:

(1) Diameter 2 inches.
 (2) Total Depth 145 feet.
 (3) Water Level 80 feet below top of ground.
 (4) Cased to 113, Size 2"
 (5) Screen: Size 1 1/4, Length 6 ft.
 (6) Were any formations sealed against pollution?
 _____ yes, _____ X no.

If YES depth of formation _____
 Why _____
 Drillers Remarks: 325 gal per hour

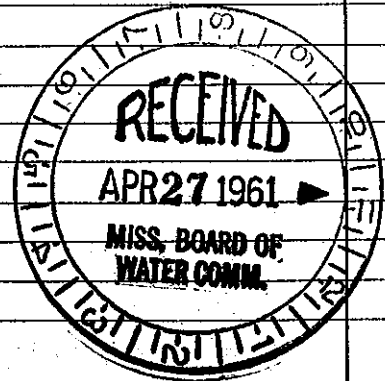

Well No.

(Use Back Side)

Retain this copy for your office files.