

LEAKE MISSISSIPPI BOARD OF WATER COMMISSIONERS

P 18
8-8-63

WATER WELL DRILLERS LOG

CODED

Leske
Leake

Date: 8/8, 1963, Driller: Just Drilling County Leake

(Name)

(1) Owner of Land:	Description & Color of Materials Sand, Clay, Red Clay, Shell, etc.	Thick- ness Feet	Depth Feet
<u>Clennie J. J. J.</u> (Name) <u>Walnut Grove, Miss</u> (Address)	<u>Red Clay</u>	<u>0</u>	<u>15</u>
(2) Location: <u>1/4, 27, 8</u> T. R., <u>1</u> miles <u>North</u> of <u>W.N.M.</u> (distance) (direction) (Nearest Town)	<u>Sand</u>		<u>24</u>
	<u>Clay + Sand</u>		<u>42</u>
	<u>Sand + Sh. Clay</u>		<u>102</u>
(3) Topography: <u>X</u> (Hilly) (Flat) (Level)	<u>Clay</u>		<u>110</u>
	<u>Fine Sand</u>		<u>122</u>
(4) Purpose of Well: <u>Home</u> (Domestic Irrigation Municipal, Industrial, Other)	<u>Med Sand</u>		<u>130</u>

Information upon completion of well:


- (1) Diameter 2 inches.
- (2) Total Depth 130 feet.
- (3) Water Level 58 feet below top of ground.
- (4) Cased to 125ft, Size 2"
- (5) Screen: Size 2", Length 5ft.
- (6) Were any formations sealed against pollution?
 yes, no.

If YES depth of formation _____

Why _____

Drillers Remarks: _____

~~5540~~

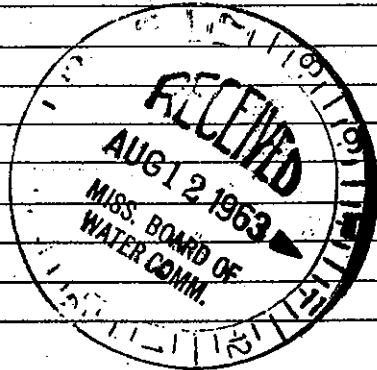

Well No.

(Use Back Side)

Mail this copy to Board of Water Commissioners 429 Miss. St. Jackson, Miss.