

LEAKE  
Q1

WATER WELL DRILLERS LOG

CODED

Date: 9-17-62 Driller: Marshall Conrad County: Leake  
(Name)

(1) Owner of Land: Lamar Sistrunk  
 (Name)  
Rt #1 Union, Miss.  
 (Address)

(2) Location: 1/4, 1/4, Sec 25 T9 R9  
3 miles East of Sobon Top  
 (distance) (direction) (Nearest Town)

(3) Topography: X  
 (Hilly) (Flat) (Level)

(4) Purpose of Well:  
 (Domestic Irrigation  
 Municipal, Industrial, Other)

Description & Color of Materials Sand, Clay, Red Clay, Shell, etc.	Thick- ness Feet	Depth Feet
<del>0 to 95 feet sand course in part</del>	<del></del>	<del></del>
<del>95 to 100 feet drilling 102 to 125 dark clay 125 to 140 dark clay looks like yellow clay.</del>	<del></del>	<del></del>

Information upon completion of well:

(1) Diameter 7 inches.

(2) Total Depth 215 feet.

(3) Water Level \_\_\_\_\_ feet below top of ground.

(4) Cased to 157 feet, Size 2"

(5) Screen: Size \_\_\_\_\_, Length \_\_\_\_\_


(6) Were any formations sealed against pollution?  
 \_\_\_\_\_ yes, \_\_\_\_\_ no.

<u>Sand - coarse</u>	<u>0-95</u>	
<u>Very Dark Clay</u>	<u>95-102</u>	
<u>Very Dark Sand</u>	<u>102-125</u>	
<u>Yellow Clay</u>	<u>125-185</u>	
<u>Green sand of the Minona Group.</u>	<u>185-215</u>	

If YES depth of formation \_\_\_\_\_

Why \_\_\_\_\_

Drillers Remarks: \_\_\_\_\_

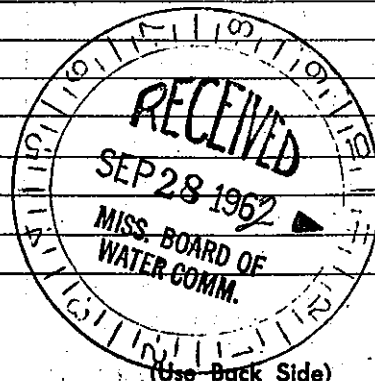

Well No.

Retain this copy for your office files.