

LEAKE MISSISSIPPI BOARD OF WATER COMMISSIONERS

CODED

Q 2
6-4-63

WATER WELL DRILLERS LOG

Date: 6-4, 1963, Driller: M. Conrad County: Leake
(Name)

(1) Owner of Land:	Description & Color of Materials Sand, Clay, Red Clay, Shell, etc.	Thick- ness Feet	Depth Feet
<u>L. M. Conrad</u> (Name) <u>Walnut Grove 2</u> (Address)	<u>Chalk + Clay</u>	<u>0</u>	<u>75</u>
	<u>Sportsman</u>	<u>75</u>	<u>210</u>
(2) Location: <u>1/4</u> , <u>1/4</u> , Sec <u>26 T9 R9</u> , <u>3</u> miles <u>N</u> of <u>Sublet</u> (distance) (direction) (Nearest Town)	<u>Rock + Dark Sand</u>	<u>210</u>	<u>220</u>
	<u>Rock Lumps + Dark</u>		
	<u>Sand To</u>	<u>260</u>	
(3) Topography: <u>H</u> (Hilly) (Flat) (Level)	<u>Alpha Clay</u>	<u>260</u>	<u>340</u>
(4) Purpose of Well: <u>D</u> (Domestic Irrigation Municipal, Industrial, Other)	<u>Musonsa Sand</u>	<u>340</u>	<u>389</u>
	<u>Chalk + Hard</u>		
	<u>Rock Layers</u>	<u>389</u>	<u>419</u>

Information upon completion of well:


- (1) Diameter 2 inches.
- (2) Total Depth 419 feet.
- (3) Water Level 147 feet below top of ground.
- (4) Cased to 263, Size _____.
- (5) Screen: Size _____, Length _____.
- (6) Were any formations sealed against pollution?
_____ yes, _____ no.

If YES depth of formation _____

Why _____

Drillers Remarks: _____

Open Well

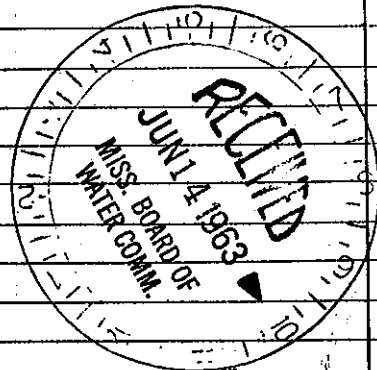

(Use Back Side)

Well No.

tain this copy for your office files.