

MISSISSIPPI BOARD OF WATER COMMISSIONERS

LEE

A

WATER WELL DRILLERS LOG

A301

5-29-60

HERNDON WELL & SUPPLY CO.

Date May 29, 1961, Driller: P. O. BOX 42 County Lee

SHANNON, MISSISSIPPI

(1) Owner of Land:	Description & Color of Materials Sand, Clay, Red Clay, Shell, etc.	Thick- ness Feet	Depth Feet
Name: <u>Rayce McBray</u> Address: <u>127 1 Courtown, Miss</u>	<u>Surface sand</u> <u>& clay</u>	<u>0</u>	<u>0</u>
Location: <u>1/4, 1/4, Sec 24 T185E</u> miles <u>West of Courtown</u> (distance) (direction) (Nearest Town)	<u>Blue silt</u> <u>sand</u>	<u>18</u> <u>160</u>	
Topography: <u>Flat</u> (Hilly) (Flat) (Level)			
Purpose of Well: <u>Domestic</u> (Domestic Irrigation Municipal, Industrial, Other)	<u>Bottom</u>	<u>280</u>	


Information upon completion of well:

- (1) Diameter 4 inches.
- (2) Total Depth 280 feet.
- (3) Water Level 40 feet below top of ground.
- (4) Cased to 22' 2", Size 4"
- (5) Screen: Size , Length
- (6) Were any formations sealed against pollution?
 yes, no.

If YES depth of formation 18 ft.

Why Siltstone & Sand

Drillers Remarks:

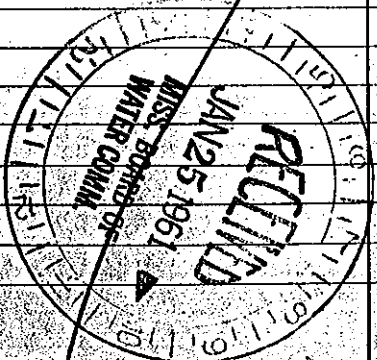

(Use Back Side)

Well No.