

See
A 2000
8-68

MISSISSIPPI BOARD OF WATER COMMISSIONERS

WATER WELL DRILLERS LOG

J. W. Webb & Sons
J. C. Webb, Jr.

Date: 8-16, 1968, Driller: J. C. Webb, Jr., County: Lee
(When well drilled) (Name) (Where well is located)

(1) Owner of Land:	Description & Color of Materials Sand, Clay, Red Clay, Shell, etc.	Thick- ness Feet	Depth Feet
Albert Hamblin (Name) Guntown, Miss. (Address)	CLAY	0	15
NW 1/4, SE 1/4, Sec. 10 T5R2E (Location)	Blue MARI	15	188
8 miles SW of Braidwyn (distance) (direction) (Nearest Town)	Grey SAND	188	300
(3) Topography: Hilly (Hilly) (Flat) (Level)	Blue MARI	300	320
(4) Purpose of Well: DOMESTIC (Domestic Irrigation Municipal, Industrial, Other)			


Information upon completion of well:

- (1) Diameter 5 inches.
- (2) Total Depth 320 feet.
- (3) Water Level 110 feet below top of ground.
- (4) Cased to 21, Size 5"
- (5) Screen: Size None, Length _____
- (6) Were any formations sealed against pollution?
_____yes, _____no.

If YES depth of formation _____

Why _____

Drillers Remarks: Well ONLY
Yield in gpm: _____
Size pump: _____
Type power: _____

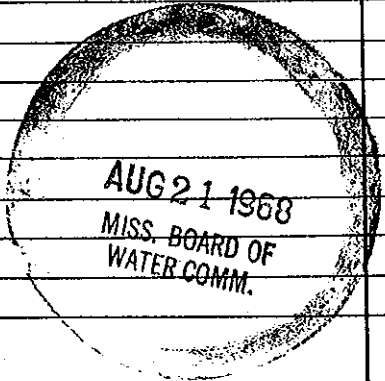

Mail this copy to Board of Water Commissioners 429 Miss. St. Jackson, Miss.