

MISSISSIPPI DEPARTMENT OF ENVIRONMENTAL QUALITY
Bureau of Land and Water Resources

P. O. Box 10631
Jackson, MS 39289-0631
WATER WELL DRILLERS LOG

COUNTY WELL LOCATED <u>Lee</u>	
WELL NUMBER <u>B 2011</u>	CODED
DATE WELL COMPLETED <u>10/2/93</u>	

PERMIT NUMBER
NAME OF DRILLING FIRM <u>Herndon Well & Supply</u>
<u>Shannon, MS</u>

NAME & MAILING ADDRESS OF LANDOWNER <u>Ralph Pounds</u>		
<u>P O Box</u>		
<u>Tupelo, MS 38801</u>		
WELL LOCATION: SEC	TOWNSHIP	RANGE
<u>10</u>	<u>7 S</u>	<u>6 E</u>
DISTANCE	DIRECTION	NEAREST TOWN
<u>1</u> Miles	<u>W</u>	of <u>Baldwyn</u>
OTHER LANDMARK		
WELL PURPOSE: Home, Irrigation, Municipal, Industrial, Fish Pond, etc. <u>Home</u>		

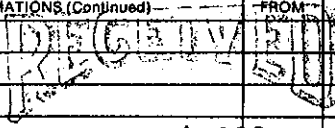
PUMP DATA		
PUMP TYPE (Circle One): <input checked="" type="radio"/> Submersible Turbine Jet Flowing Well, Other (Describe) _____		
POWER TYPE (Circle One): <input checked="" type="radio"/> Electric Tractor Diesel Gasoline Butane, Other (Describe) _____ H/P <u>1/2</u>		
Pump Capacity (GPM) <u>7</u>	No. of Stages <u>11</u>	Setting Depth <u>231</u> FT.
PUMP TEST		
Well yielded _____ GPM with a drawdown of _____ ft. after _____ hours of pumping		

WELL DATA		
Well Depth <u>284'</u>	Casing Diameter (in.) <u>4"</u>	Casing Length (Ft.) <u>27'</u>
Type of Casing <u>PVC</u>	Hole Depth <u>284'</u>	Depth to Static Water Level
TYPE OF COMPLETION: (Circle One or More): <input checked="" type="radio"/> Gravel Packed, Underreamed, Telescoped, Natural Development, Open Hole, Other (Describe) _____		
Top of Lap Pipe or Reduction in Casing		
FEET IF TELESCOPED OR MORE THAN ONE SCREEN: USE BACK PAGE		

LOG DATA	
TYPE OF LOG RUN (Circle One): Electric, Gamma Ray, Density, Sonic, <input checked="" type="radio"/> No Log Run, Neutron, Other (Describe) _____	
Name of Organization Running Log	

SCREEN DATA		
Diameter - Inches <u>4"</u>	Length - Feet <u>10'</u>	Slot Size - Inches
Screen Type <u>PVC</u>	Depth to Bottom - Feet	

GEOLOGIC DATA (Office Use Only)			
Surface Elev.	Geologic Unit	Unit Thickness	Depth to Top
Subs. SWL	Date	Analysis	Aquifer Test
Driller's Remarks			

DESCRIPTION OF FORMATIONS ENCOUNTERED	FROM	TO	FORMATIONS (Continued)	FROM	TO
<u>Brown Sand</u>	<u>0</u>	<u>20</u>	 <u>NOV 04 1993</u> Dept. of Environmental Quality Office of Land & Water Resources		
<u>Blue Rock</u>	<u>20</u>	<u>45</u>			
<u>Sandy Clay</u>	<u>45</u>	<u>284</u>			

IF MORE SPACE IS NEEDED, USE BACK