

B **WATER WELL DRILLERS LOG** *Mouse*

Date: *12-31-60*, 1960, Driller: *Ewing Gas Co.* County *For*

(1) Owner of Land: *Dick Richardson*
(Name)
Nettleton, Miss.
(Address)

(2) Location: $\frac{1}{4}$, $\frac{1}{4}$, Sec. *16* *12S 7E* T R
3 miles *SE* of *Nettleton*
(distance) (direction) (Nearest Town)

(3) Topography: (Hilly) (Flat) (Level)

(4) Purpose of Well: *Household*
(Domestic Irrigation, Municipal, Industrial, Other)

Description & Color of Materials Sand, Clay, Red Clay, Shell, etc.	Thick- ness Feet	Depth Feet
<i>Red Clay</i>	<i>0</i>	<i>30</i>
<i>Blue Clay</i>	<i>30</i>	<i>70</i>
<i>Sand</i>	<i>70</i>	<i>165</i>

Information upon completion of well:

(1) Diameter *4* inches.

(2) Total Depth *165* feet.

(3) Water Level *30* feet below top of ground.

(4) Cased to *30'*, Size _____


(5) Screen: Size _____, Length _____

(6) Were any formations sealed against pollution?
 yes, _____ no.

If YES depth of formation *30'*

Why _____

Drillers Remarks: _____

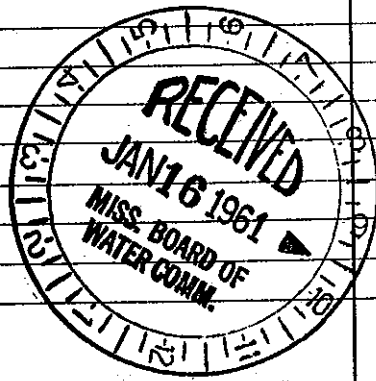

(Use Back Side)

Well No. _____

268

Mail this copy to Board of Water Commissioners 429 Miss. St. Jackson, Miss.