

MISSISSIPPI BOARD OF WATER COMMISSIONERS

WATER WELL DRILLERS LOG

HERNDON WELL & SUPPLY CO.


Date June 20, 1960, Driller: P. O. BOX 42 County Lee
SHANNON, MISSISSIPPI

(1) Owner of Land (Name) (Address)	Description & Color of Materials Sand, Clay, Red Clay, Shell, etc.	Thick- ness Feet	Depth Feet
<u>County Spontaneous</u> <u>Wake, Gauttard, Miss</u>	<u>Surface sand</u> <u>& clay</u>		<u>0</u>
(2) Location: $\frac{1}{4}$, $\frac{1}{4}$, Sec <u>26 T 12 R 6E</u>	<u>Blue rock</u>		<u>260</u>
<u>1</u> miles <u>East</u> of <u>Gauttard</u> (distance) (direction) (Nearest Town)	<u>Sand</u>		<u>300</u>
(3) Topography: <u>Hilly</u> (Hilly) (Flat) (Level)	<u>Bottom</u>		<u>420</u>
(4) Purpose of Well: <u>Domestic</u> (Domestic Irrigation Municipal, Industrial, Other)			

Information upon completion of well:

- (1) Diameter 4 inches.
- (2) Total Depth 420 feet.
- (3) Water Level 120 feet below top of ground.
- (4) Cased to 270', Size 4"
121' 2"
- (5) Screen: Size 2", Length 30 ft
- (6) Were any formations sealed against pollution?
 yes, no.

If YES depth of formation 260
 Why Surface sand
 Drillers Remarks: no air circulation plug

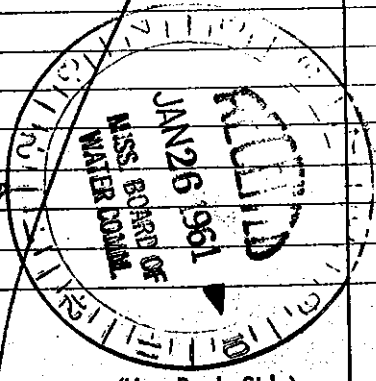

(Use Back Side)

Well No.

Mail this copy to Board of Water Commissioners 429 Miss. St. Jackson. Miss