

WATER WELL DRILLERS LOG


LEE
 Date: B792-7, 1960, Driller: Ewing Gas Co County Lee
 12-7-60

(1) Owner of Land: Mr. Elsie Weatherford
 (Name)
Baldwyn, Miss.
 (Address)

(2) Location: SE 1/4, SE 1/4, Sec. 4 T7R6E
 miles _____, of _____
 (distance) (direction) (Nearest Town)

(3) Topography: _____
 (Hilly) (Flat) (Level)

(4) Purpose of Well: Household
 (Domestic Irrigation
 Municipal, Industrial, Other)

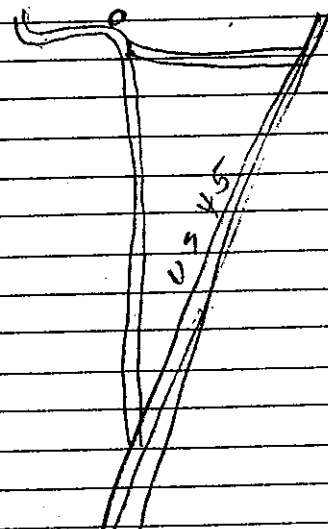Description & Color of Materials Sand, Clay, Red Clay, Shell, etc.	Thick- ness Feet	Depth Feet
<u>red brick</u>		
		
<u>ELEV WL 325</u>		

Information upon completion of well:

(1) Diameter: 4 inches.

(2) Total Depth: 411 feet.

(3) Water Level: 70 ⁸⁵ 2-14-67 feet below top of ground.

(4) Cased to 134', Size _____.


(5) Screen: Size _____, Length _____.

(6) Were any formations sealed against pollution?
 yes, _____ no.

If YES depth of formation 134'

Why _____

Drillers Remarks: _____

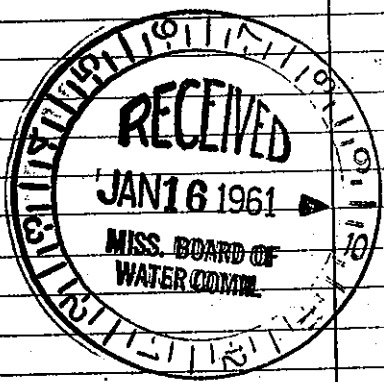

ID ELEV 410

(Use Back Side)

Well No.

Mail this copy to Board of Water Commissioners 429 Miss. St. Jackson, Miss