

LEE

MISSISSIPPI BOARD OF WATER COMMISSIONERS

B 21

6-15-62

WATER WELL DRILLERS LOG

HERNDON WELL & SUPPLY CO.

Date June 15, 1962

Driller:

P. O. BOX 42

SHANNON, MISSISSIPPI

Lee County

(1) Owner of Land:	Description & Color of Materials Sand, Clay, Red Clay, Shell, etc.	Thick- ness Feet	Depth Feet
<u>Town of Canton</u> (Name) <u>Canton, Mississippi</u> (Address)	<u>Sand & clay</u>	<u>0</u>	
(2) Location: <u>1/4, 1/4, Sec 27 45 E</u> miles (distance) of <u>Canton</u> (Nearest Town)	<u>Blue rock</u>		<u>30</u>
(3) Topography: <u>Hilly</u> (Hilly) (Flat) (Level)	<u>Sand</u>		<u>310</u>
(4) Purpose of Well: <u>Municipal</u> (Domestic Irrigation, Municipal, Industrial, Other) <u>NEW TOWN WELL</u>	<u>Bottom</u>		<u>520</u>

Information upon completion of well:



- (1) Diameter 4 inches.
- (2) Total Depth 520 feet.
- (3) Water Level 84' feet below top of ground.
- (4) Cased to 289', Size 4"
- (5) Screen: Size 2", Length 40'
- (6) Were any formations sealed against pollution?
 yes, no.

If YES depth of formation 280

Why Failure of sand
1000 gallon pressure tank

Drillers Remarks: Behind
Peoples Bank & Trust

Submersible pump - no air
20 FLD 390

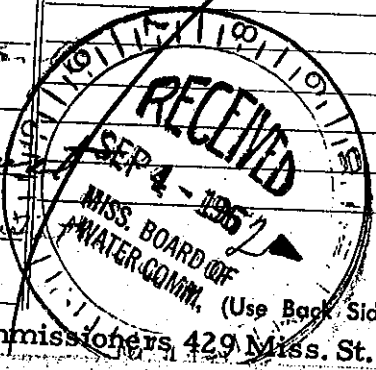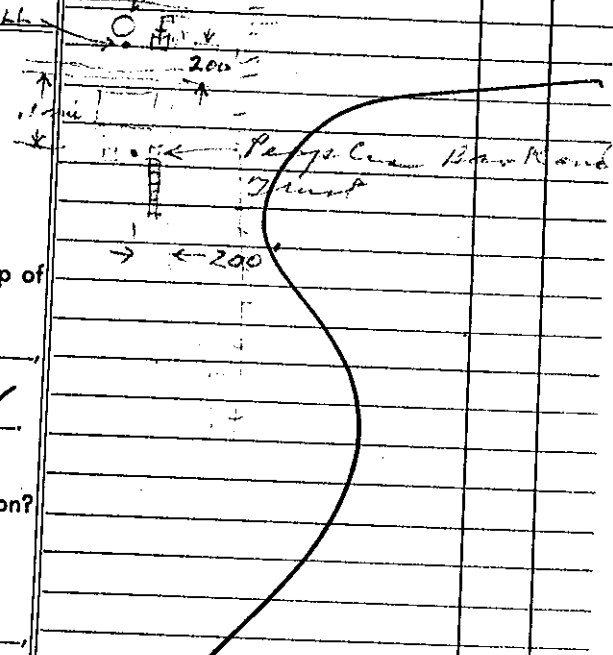

Well No.

Mail this copy to Board of Water Commissioners, 429 Miss. St. Jackson, Mis.