

LEE

MISSISSIPPI BOARD

B 23

4-25-62 WATER WELL DRILLERS LOG

Date: 4-25, 1962, Driller: O. C. Webb County: Lee

(Name)

(1) Owner of Land: Murl Murphy (Name)

Baldwyn (Address)

(2) Location: 1/4, 1/4, Sec. 9 S E T. 7 R. 6

3 miles south of Baldwyn (distance) (direction) (Nearest Town)

(3) Topography: (Hilly) (Flat) (Level)

(4) Purpose of Well: (Domestic Irrigation) (Municipal, Industrial, Other)

Description & Color of Materials Sand, Clay, Red Clay, Shell, etc.

Thick-ness Feet

Depth Feet

Soil to 15 ft. sand & clay to 35 ft. Blue Rocks to 110 ft. water Rock 8" water sand to 200 ft.

Information upon completion of well:

(1) Diameter 4 inches.

(2) Total Depth 200 feet. 42.41 2/14/67

(3) Water Level 60 feet below top of ground.

(4) Cased to 40 ft, Size 4"

(5) Screen: Size 0, Length 0

(6) Were any formations sealed against pollution?


yes, 0 no.

If YES depth of formation.

Why.

Drillers Remarks:

19 ELEV 385

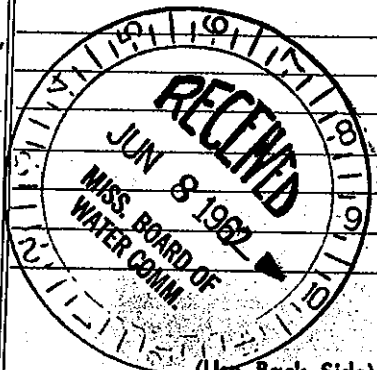

Well No.

Mail this copy to Board of Water Commissioners 429 Miss. St. Jackson, Miss.