

MISSISSIPPI BOARD OF WATER COMMISSIONERS

LEE
B-24
9-15-60

WATER WELL DRILLERS LOG
Herndon Well & Supply Co.
SHANNON, MISS.

Date: Sept 15, 1960, Driller: _____ County Lee

(1) Owner of Land: Milton Messinger
(Name)
Spartan, Miss Rt 1
(Address)
33 75 E
(2) Location: 1/4, 1/4, Sec. 22 T. 16 R. 6
2 miles South of Baldwyn
(distance) (direction) (Nearest Town)
(3) Topography: Hilly
(Hilly) (Flat) (Level)
(4) Purpose of Well: House use
(Domestic Irrigation
Municipal, Industrial, Other)

Description & Color of Materials Sand, Clay, Red Clay, Shell, etc.	Thick- ness Feet	Depth Feet
<u>Sand & Clay</u>		<u>40</u>
<u>Blue Rock</u>		<u>63</u>
<u>Sand to Bottom</u>		<u>189</u>

Information upon completion of well:

(1) Diameter 4 inches.

(2) Total Depth 189 feet.
44.20 2/15/67

(3) Water Level 60 feet below top of ground.

(4) Cased to 44', Size 4"

(5) Screen: Size _____, Length _____



(6) Were any formations sealed against pollution?
X yes, _____ no.

If YES depth of formation 40 ft

Why Surface & SAND

Drillers Remarks: _____

7 ELEV 385

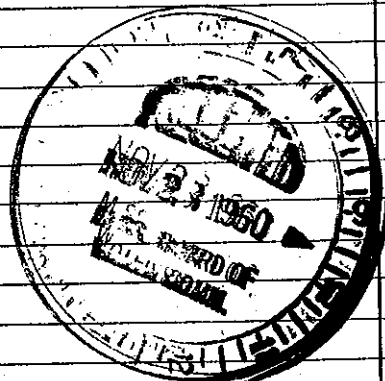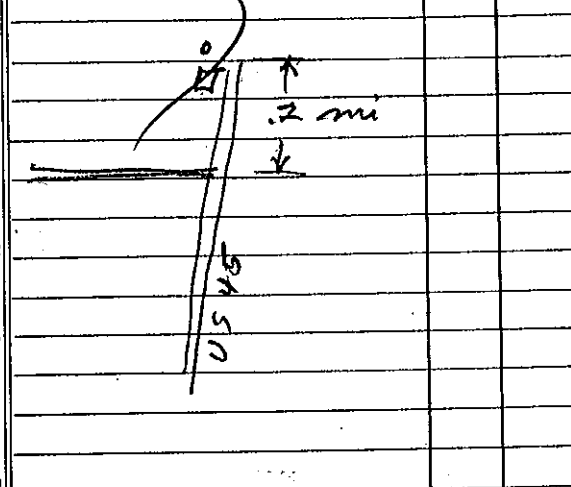

(Use Back Side)

Well No.