

LEE
B 25

WATER WELL DRILLERS LOG

Date: 8-11-60, 1960, Driller: Erving Basco County Lee
(Name)

(1) Owner of Land:	Description & Color of Materials Sand, Clay, Red Clay, Shell, etc.	Thick- ness Feet	Depth Feet
(Name) <u>Brown Capland</u>			
(Address) <u>Ballou, Miss</u>			
(2) Location: <u>SW 1/4, SW 1/4, Sec. 16, T. 2, R. 6, S. 1 E</u>	<u>East side of road</u> <u>white frame?</u>		
____ miles _____ of _____ (distance) (direction) (Nearest Town)			
(3) Topography: _____ (Hilly) (Flat) (Level)			
(4) Purpose of Well: <u>Domestic</u> (Domestic Irrigation, Municipal, Industrial, Other)			

Information upon completion of well:

(1) Diameter 4 inches.

(2) Total Depth 411 feet.

(3) Water Level 110 feet below top of ground.

(4) Cased to 92', Size 4"

(5) Screen: Size _____, Length _____


(6) Were any formations sealed against pollution?
 yes, _____ no.

If YES depth of formation 92'

Why _____

Drillers Remarks: _____

4" BLEV 375

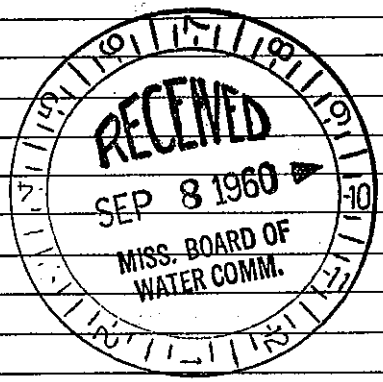

Well No.

(Use Back Side)

Mail this copy to Board of Water Commissioners 429 Miss. St. Jackson, Miss.