

CODED *coded*

Lee
B 28
2-67

MISSISSIPPI
BOARD OF WATER COMMISSIONERS
416 North State Street
Jackson, Mississippi 39201

WATER WELL DRILLERS LOG
Herndon-Homan Well & Supply, Inc.

Feb. 25 1967 date well completed
P. O. Box 42 *Lee*
SHANNON, MISSISSIPPI 38868 county well located


LANDOWNER:
S-Coast Sportsman Lake
Canton, Miss.
(mailing address)

description of formations encountered	from	to
<i>surface sand & clay</i>	<i>0</i>	<i>20</i>
<i>blue clay</i>	<i>20</i>	<i>80</i>
<i>sand</i>	<i>90</i>	<i>180</i>
<i>blue clay</i>	<i>180</i>	<i>280</i>
<i>sand</i>	<i>280</i>	<i>420</i>
<i>bottom</i>	<i>420</i>	

WELL LOCATION:
sec. *26* T *7* N R. *6* E
S W
1 miles *E* of *Canton*
(distance) (direction) (nearest town)

WELL PURPOSE: *Water*
(home, irrigation, municipal, industrial)

- WELL COMPLETION DATA:
- (1) diameter (inches) *4*"
 - (2) total depth (feet) *420*
 - (3) static water level (feet) *123* below top of ground. *300' 5"* above
 - (4) casing *steel* (material) (depth) *1'*
2" (size) if telescope see back.
 - (5) screen *40'* (length) *380'* (depth to top)
2" (size) *55* (material)
 - (6) pump *1* (HP) *10* (yield gpm)
electric (type power)
 - (7) electric log *NO* (yes or no)
(organization running log)
 - (8) how well bottom plugged *B/W*

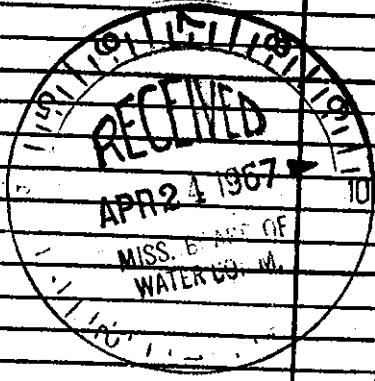

DRILLERS REMARKS: