

LEE.

B 32

WATER WELL DRILLERS LOG

?

Date: April 5, 1961, Driller: Fearing Gas Co. County Lee
4-5-61 (Name)

(1) Owner of Land: Hurley Malone
(Name)

Suntown, Miss.
(Address)

(2) Location: $\frac{1}{4}$, NE $\frac{1}{4}$, Sec. 27 T7 R6
 $\frac{1}{4}$ miles NE, of Suntown
(distance) (direction) (Nearest Town)

(3) Topography: (Hilly) (Flat) (Level)

(4) Purpose of Well: household
(Domestic Irrigation
Municipal, Industrial, Other)

Description & Color of Materials Sand, Clay, Red Clay, Shell, etc.	Thick- ness Feet	Depth Feet			

Information upon completion of well:

(1) Diameter 4 inches.

(2) Total Depth 432 feet.

(3) Water Level 110 feet below top of ground.

(4) Cased to 6, Size _____

(5) Screen: Size _____, Length _____

(6) Were any formations sealed against pollution?
_____ yes, _____ no.


yes, _____ no.

If YES depth of formation 6'

Why _____

Drillers Remarks: _____

10 ELEV 410

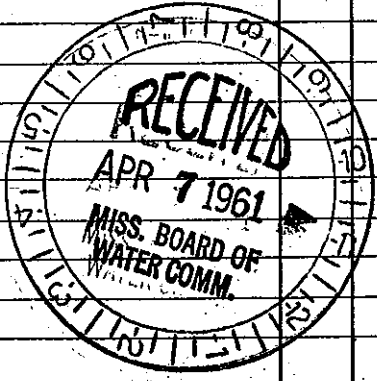

(Use Back Side)

Well No.

Mail this copy to Board of Water Commissioners 429 Miss. St. Jackson, Miss.