

LEE MISSISSIPPI BOARD OF WATER COMMISSIONERS


BBA

10-7-63

WATER WELL DRILLERS LOG

Date: 10/7, 1963, Driller: HERNDON WELL & SUPPLY CO. P.O. BOX 42 County: Lee SHANNON (Name) MISSISSIPPI

(1) Owner of Land: <u>Bill Hall</u> (Name)	Description & Color of Materials Sand, Clay, Red Clay, Shell, etc.	Thick- ness Feet	Depth Feet
<u>(Contractor) Guntown, Miss</u> (Address)	<u>surface sand & clay</u>		<u>0</u>
(2) Location: <u>28 75 E</u> <u>1</u> miles <u>W</u> of <u>Guntown</u> (distance) (direction) (Nearest Town)	<u>Blue sand</u>		<u>70</u>
(3) Topography: <u>flat</u> (Hills) (Flat) (Level)	<u>sand</u>		<u>100</u>
(4) Purpose of Well: <u>Domestic</u> (Domestic Irrigation Municipal, Industrial, Other)	<u>Blue sand</u>		<u>189</u>
Information upon completion of well:			
(1) Diameter: <u>4</u> inches.	<u>sand</u>		<u>240</u>
(2) Total Depth: <u>480</u> feet.	<u>Bottom</u>		<u>480</u>
(3) Water Level: <u>90</u> feet below top of ground.			
(4) Cased to: <u>19 1/2"</u> , Size <u>4"</u>			
(5) Screen: Size <u>—</u> , Length <u>—</u>			
(6) Were any formations sealed against pollution? <u>yes</u> , <u>no</u> .			
If YES depth of formation: <u>189'</u>			
Why: <u>surface & sand</u>			
Drillers Remarks: <u>new subdivision</u>			

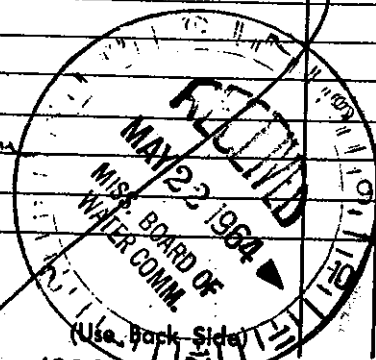

Well No.

Mail this copy to Board of Water Commissioners 429 Miss. St. Jackson, Miss.